




图号：41001	通告项号：2025 - 292
版时：2022.08	前次项号：2025 - 186



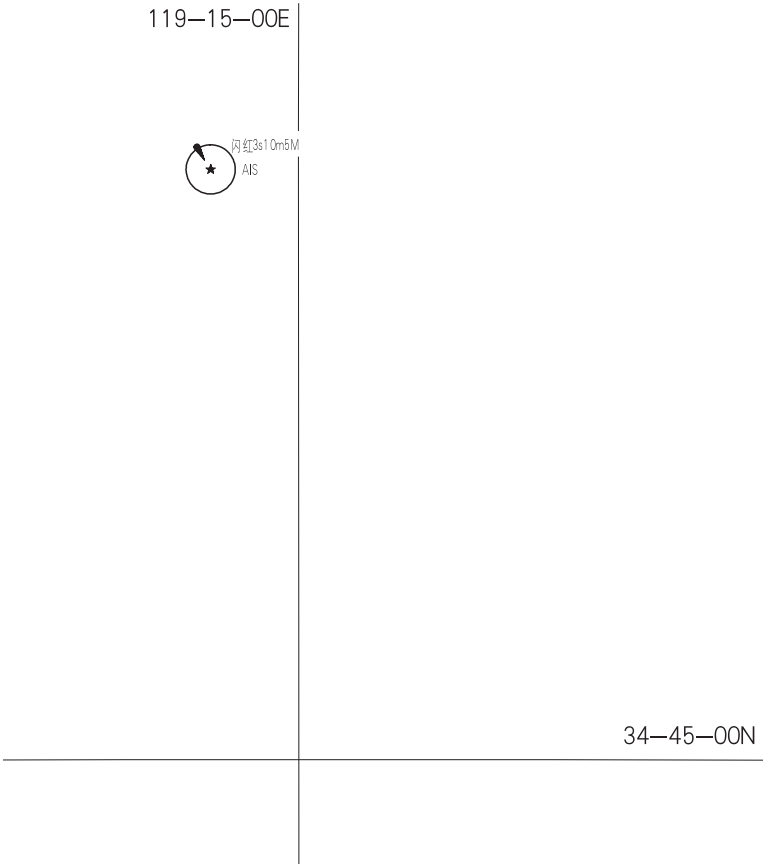

图号：41001	通告项号：2025 - 293
版时：2022.08	前次项号：2025 - 292

34—45—00N

田湾导流堤(1) 莫(C) 黄12s12m4M

119—30—00E



图号：41101	通告项号：2025 - 293
版时：2018.08	前次项号：2025 - 186

119—30—00E

(4) 莫(C) 黄12s13m4M 同步

(3) 莫(C) 黄12s13m4M 同步


(2) 莫(C) 黄12s12m4M 同步

34—40—00N

田湾导流堤(1) 莫(C) 黄12s12m4M 同步




图号：41101	通告项号：2025 - 294
版时：2018.08	前次项号：2025 - 293

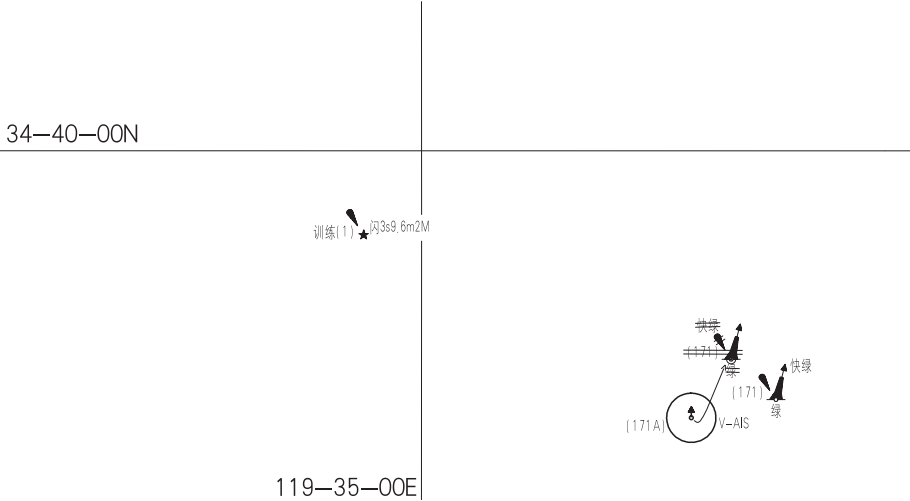




图号：41122	通告项号：2025 - 293
版时：2022.11	前次项号：2025 - 186

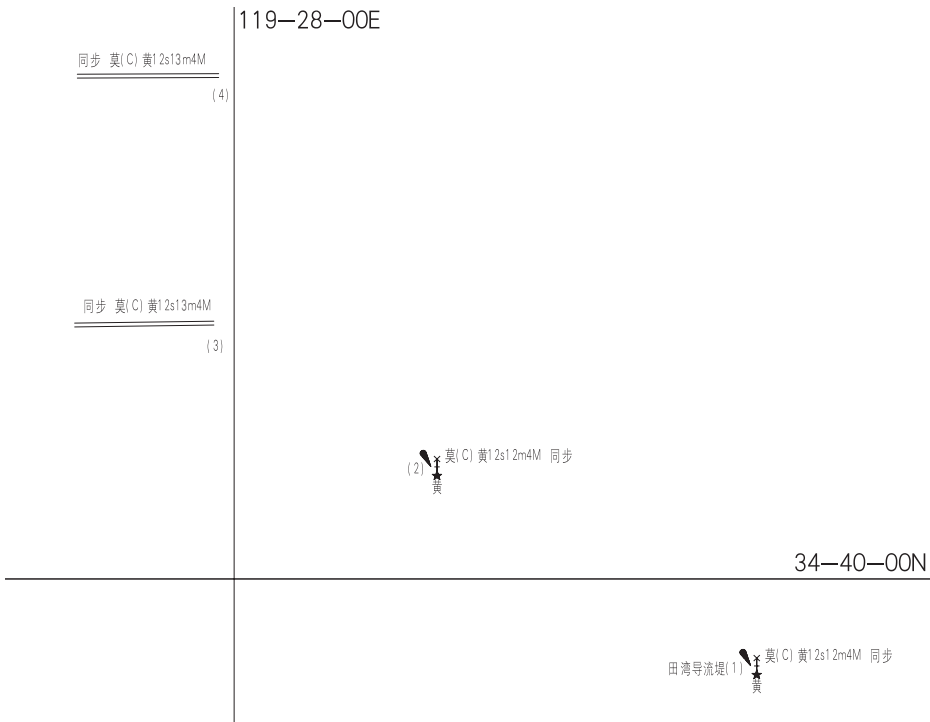




图号：41122	通告项号：2025 - 294
版时：2022.11	前次项号：2025 - 293

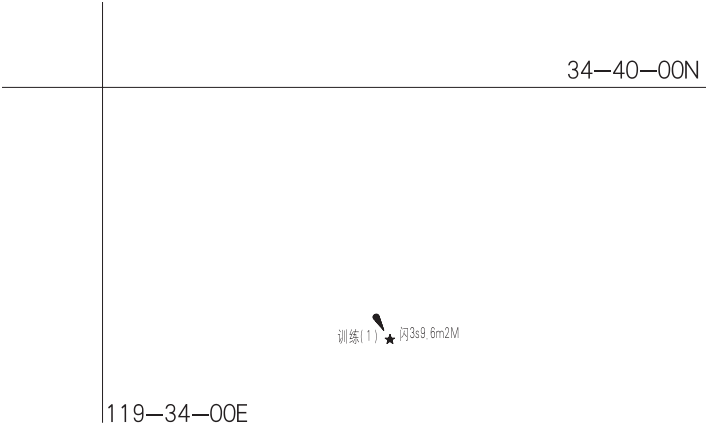


图号：41321	通告项号：2025 - 293
版时：2025.01	前次项号：2025 - 186

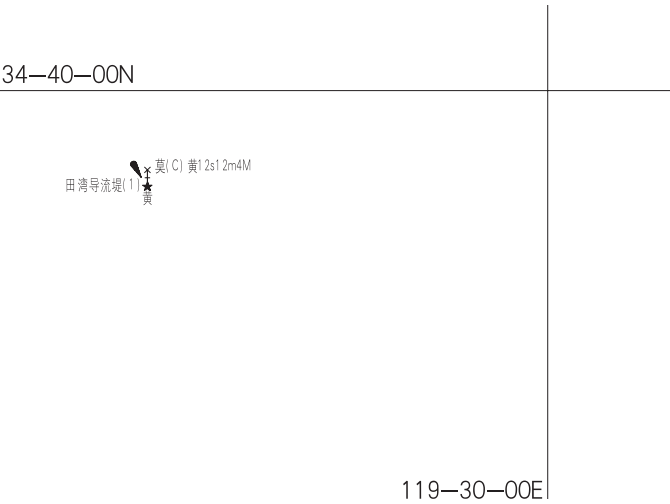




图号：41321	通告项号：2025 - 294
版时：2025.01	前次项号：2025 - 293

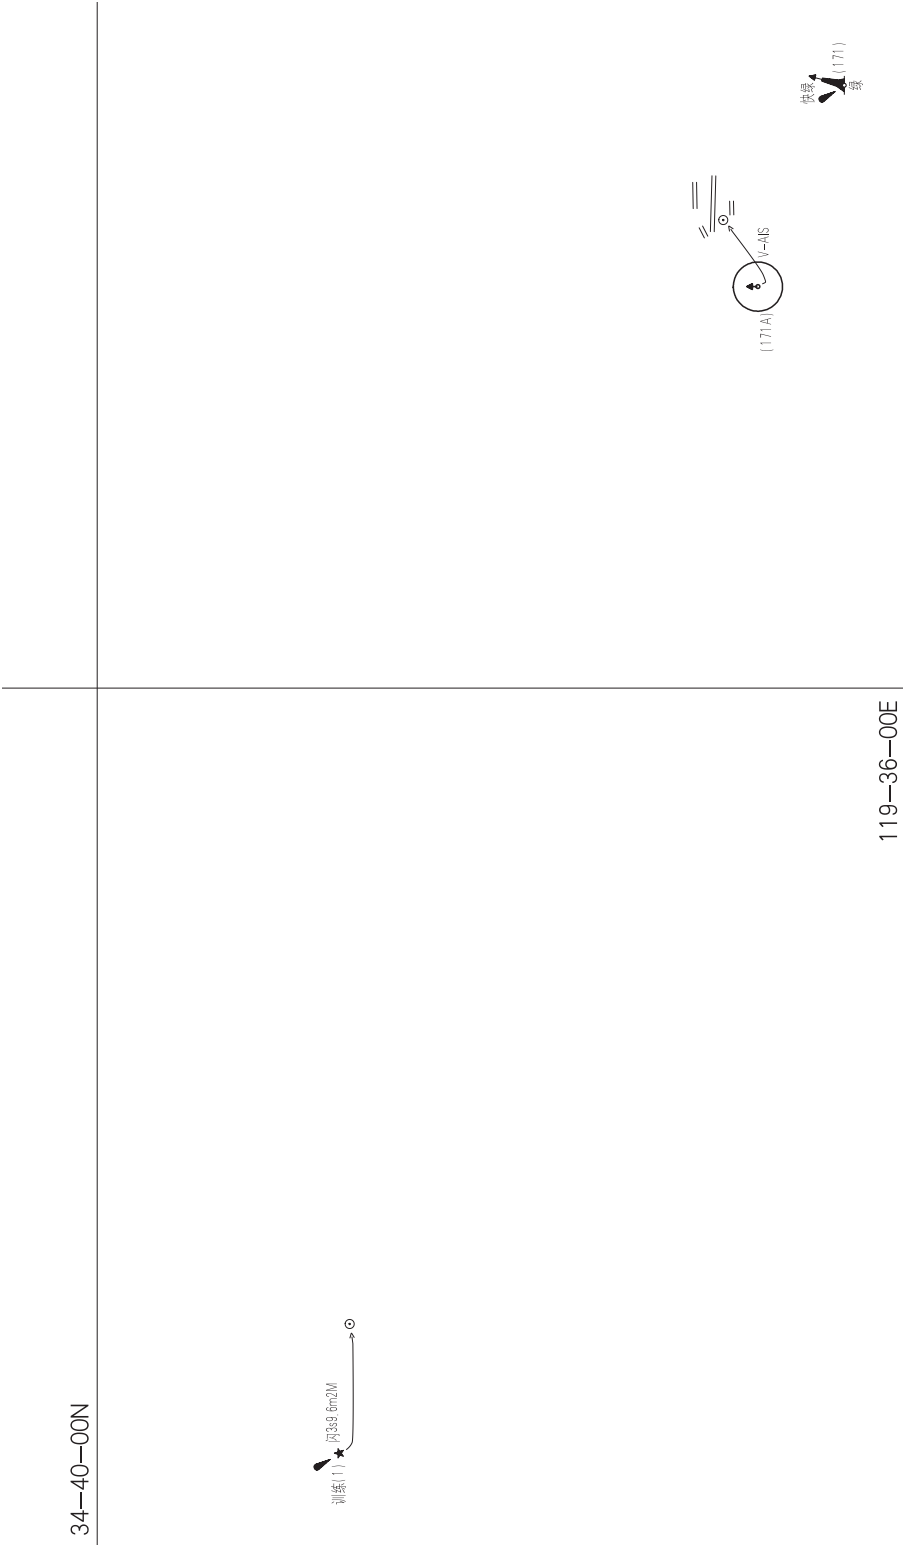




图号：41451	通告项号：2025 - 292
版时：2021.02	前次项号：2024 - 1332

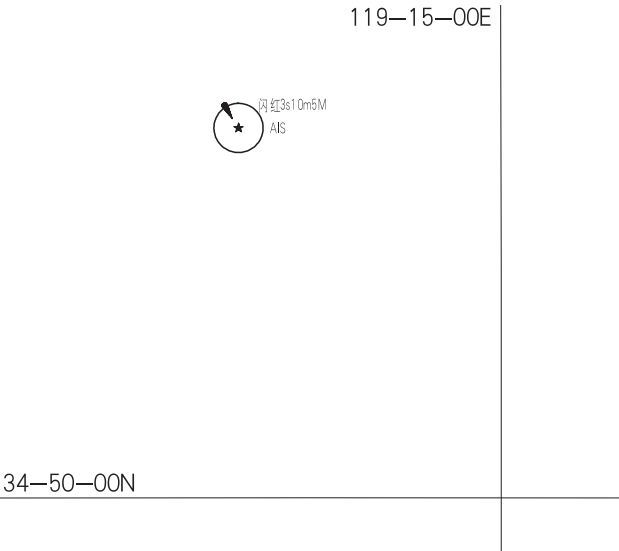




图号：42001	通告项号：2025 - 295
版时：2022.09	前次项号：2024 - 1086

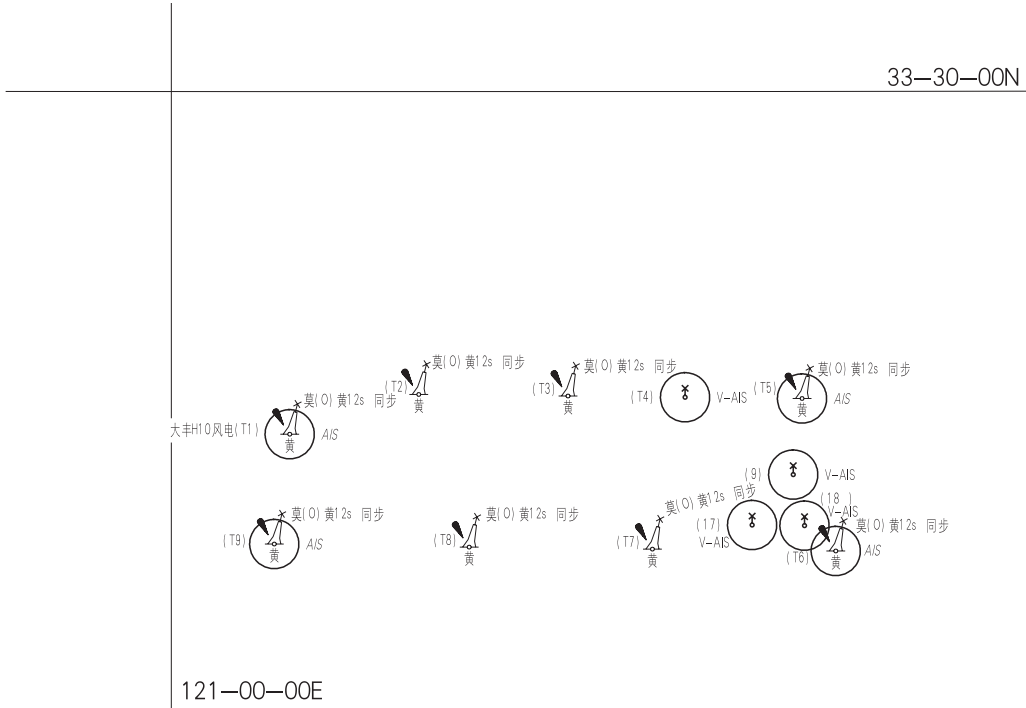




图号：42002	通告项号：2025 - 295
版时：2020.06	前次项号：2025 - 249

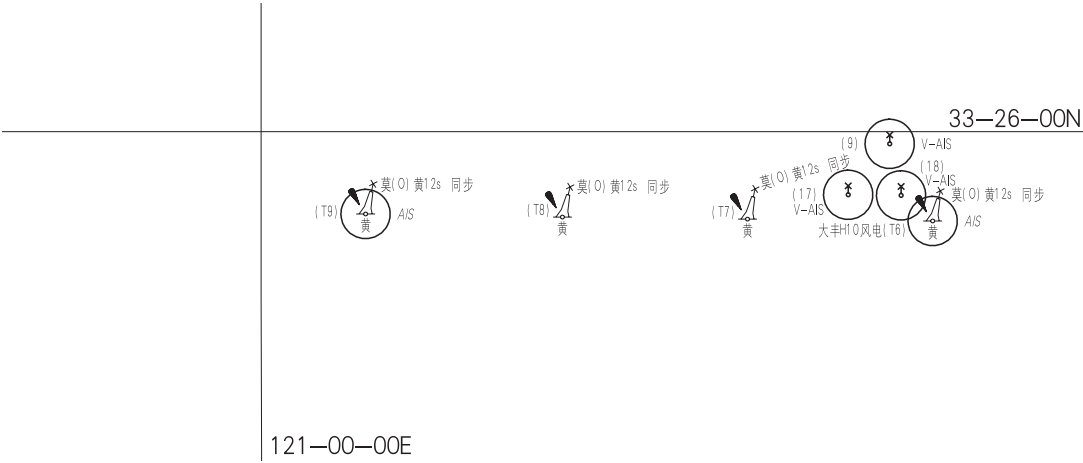




图号：42002	通告项号：2025 - 296
版时：2020.06	前次项号：2025 - 295

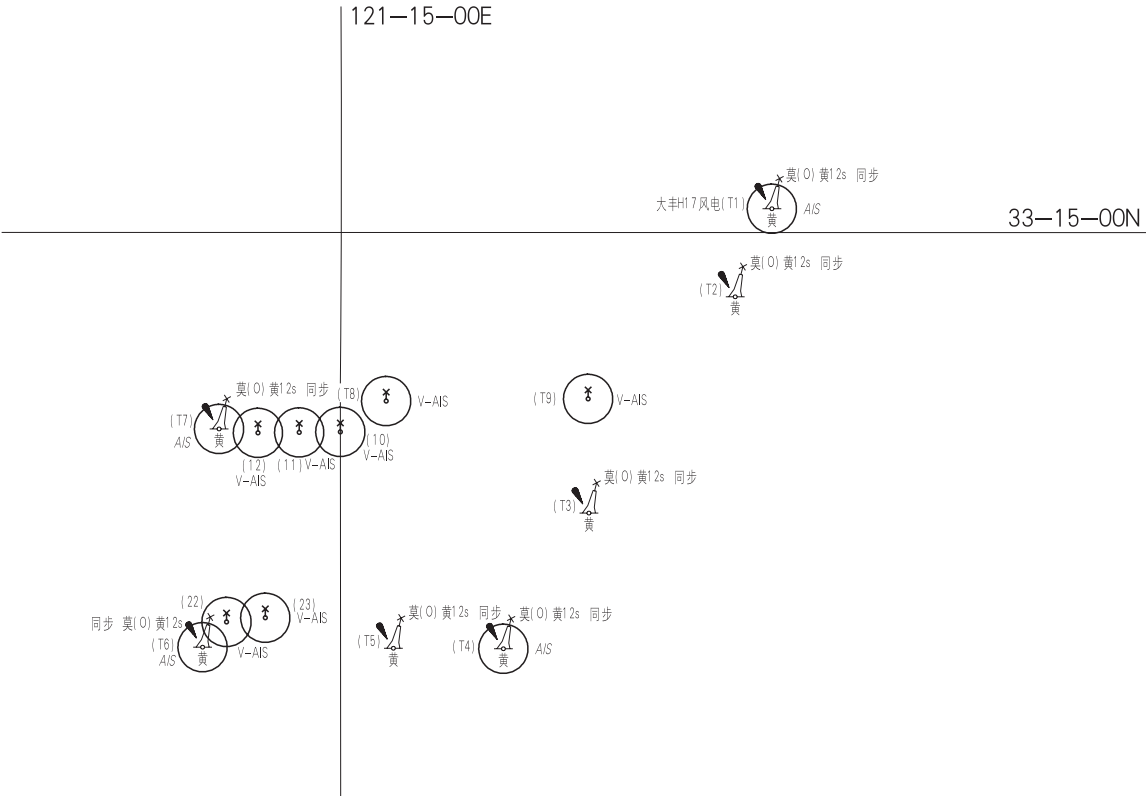




图号：44124	通告项号：2025 - 297
版时：2025.01	前次项号：2025 - 250

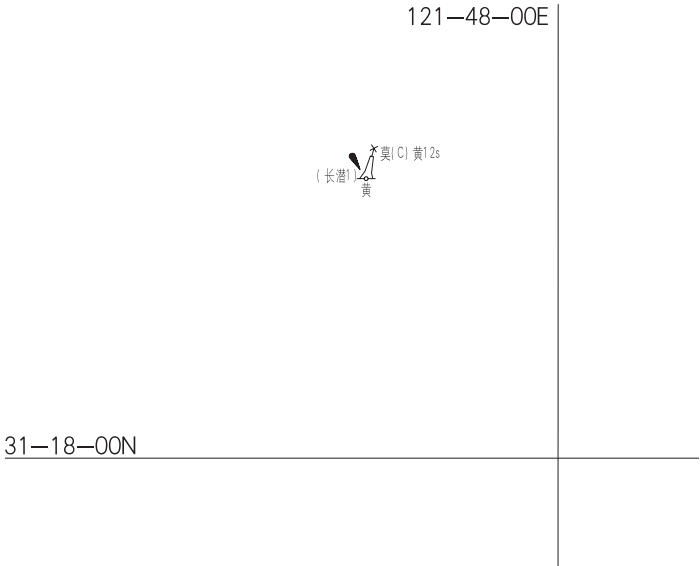


图号：44135	通告项号：2025 - 297
版时：2023.11	前次项号：2023 - 1137

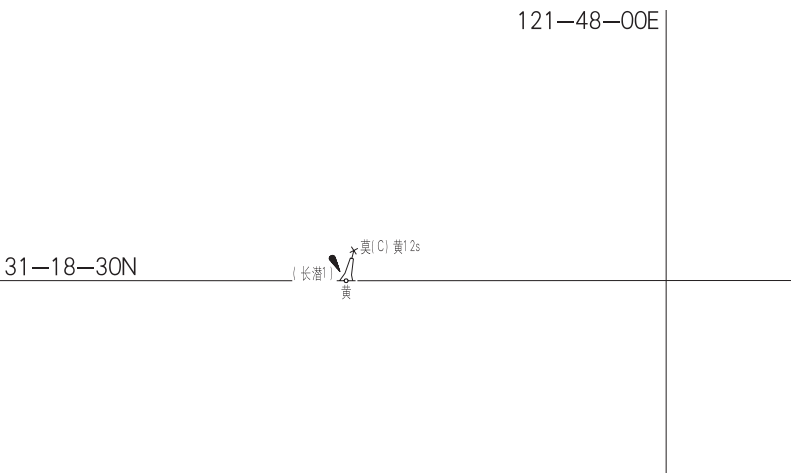




图号：51001	通告项号：2025 - 298
版时：2021.09	前次项号：2025 - 253

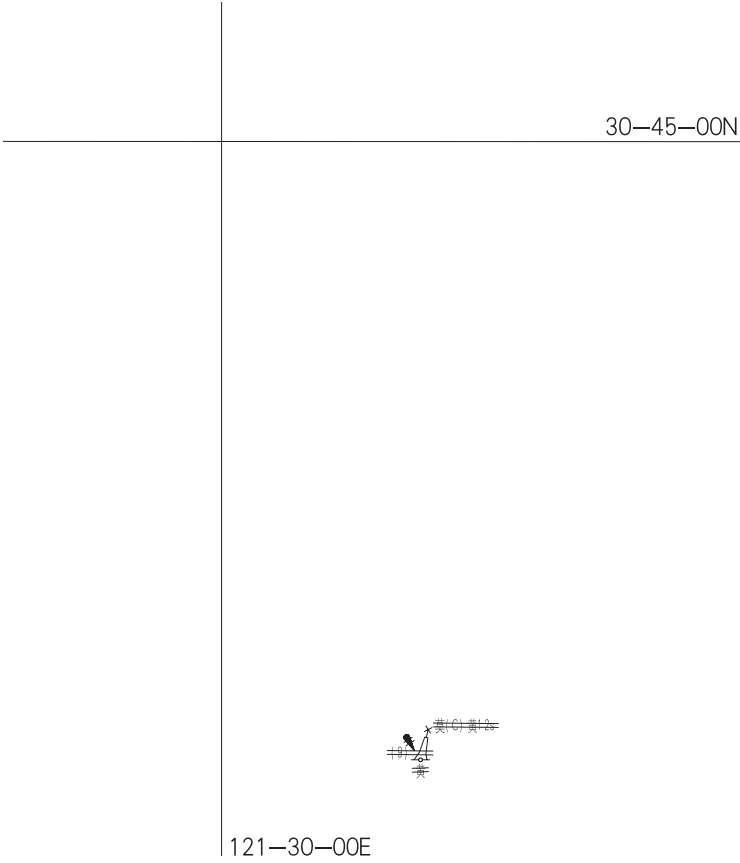




图号：51001	通告项号：2025 - 299
版时：2021.09	前次项号：2025 - 298

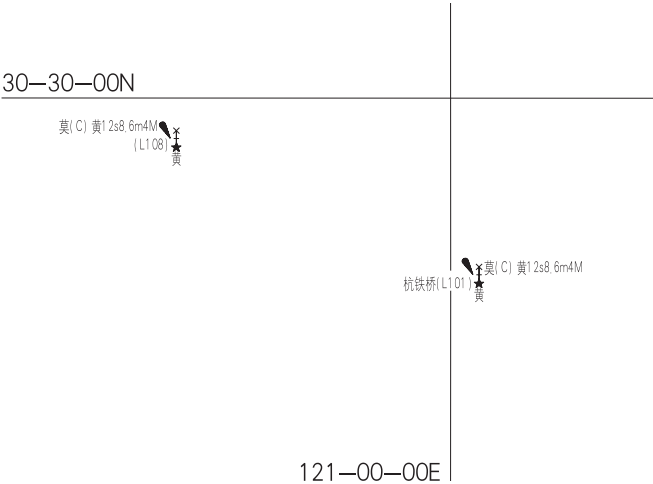


图号：51001	通告项号：2025 - 299
版时：2021.09	前次项号：2025 - 298

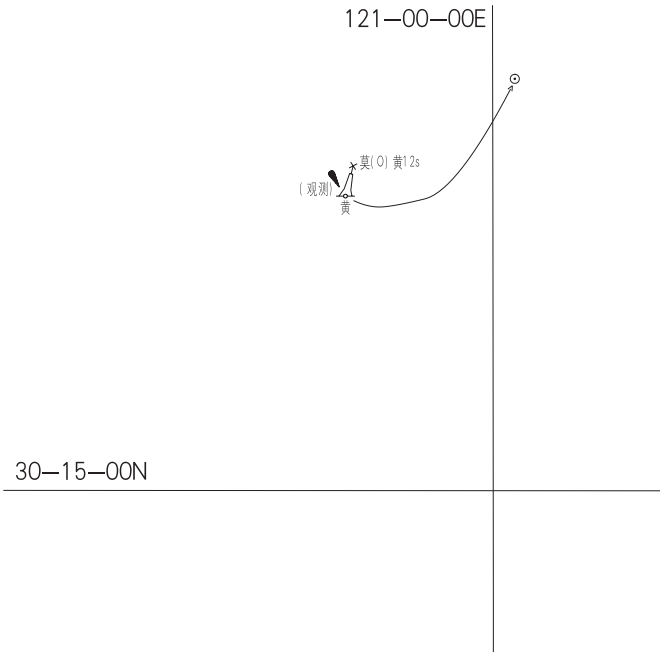



图号：51122	通告项号：2025 - 299
版时：2024.12	前次项号：2024 -


30—34—00N

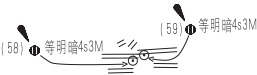


121—04—00E



图号：51123	通告项号：2025 - 299
版时：2024.12	前次项号：2025 - 192

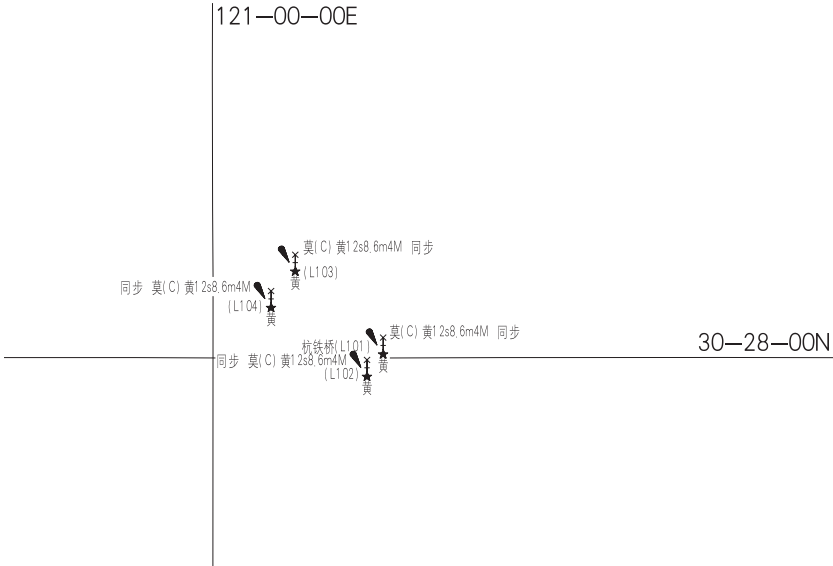


图号：51123	通告项号：2025 - 299
版时：2024.12	前次项号：2025 - 192

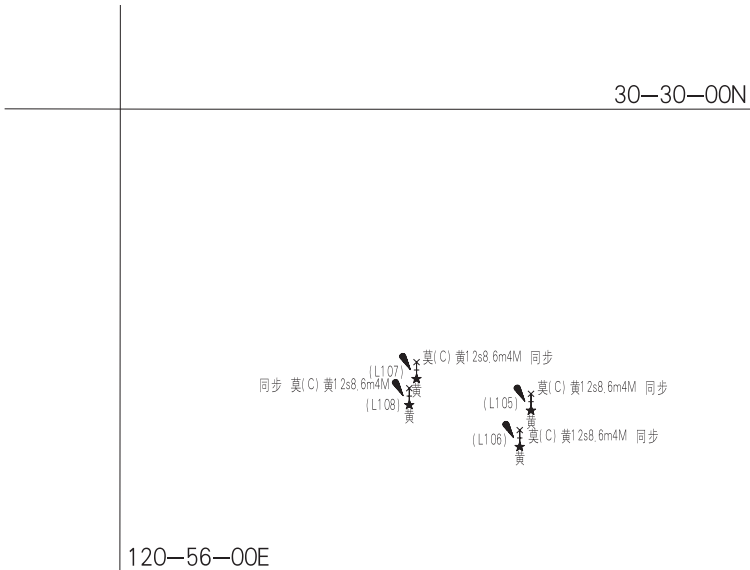




图号：51123	通告项号：2025 - 299
版时：2024.12	前次项号：2025 - 192

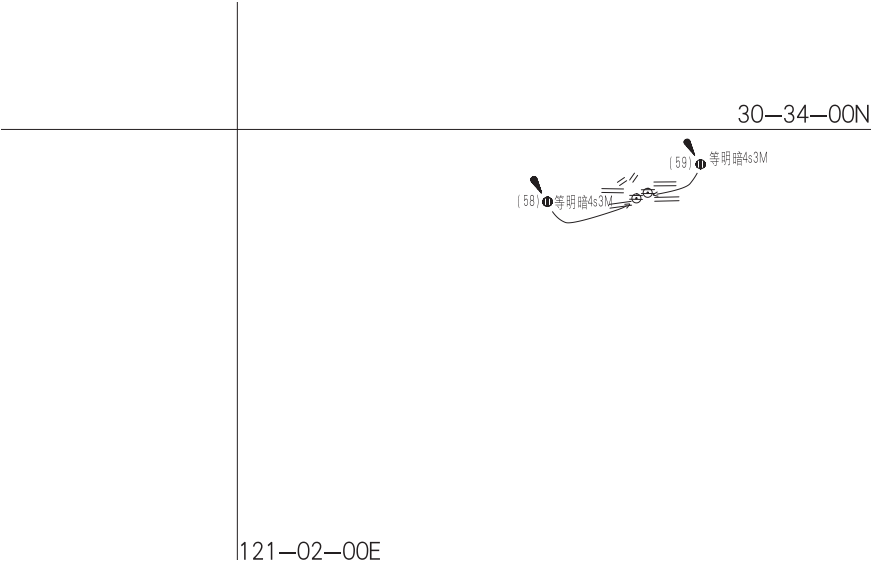

图号：51171	通告项号：2025 - 298
版时：2019.08	前次项号：2025 - 253

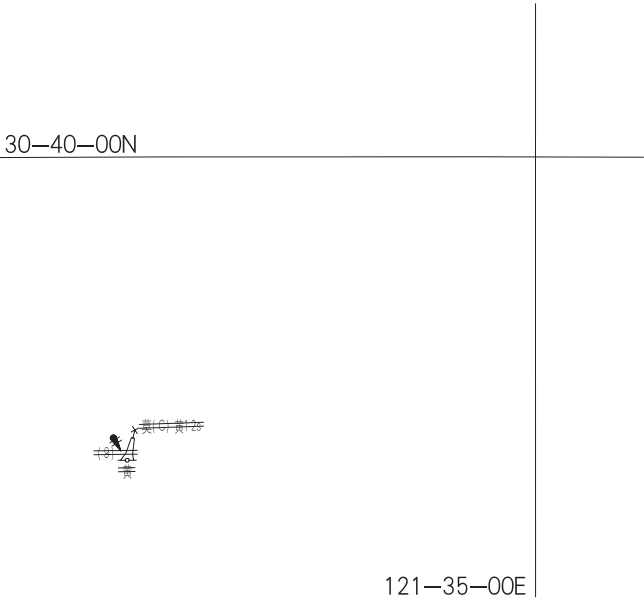



图号：51172	通告项号：2025 - 299
版时：2019.08	前次项号：2025 - 192

30-30-00N


同步 莫(C) 黄1 2s8.6m4M (L108) 黄 莫(C) 黄1 2s8.6m4M 同步 (L105) 黄

同闪 莫(C) 黄1 2s8.6m4M (L104) 黄 莫(C) 黄1 2s8.6m4M 同闪 杭铁桥(L101) 黄

121-00-00E




图号：51172	通告项号：2025 - 299
版时：2019.08	前次项号：2025 - 192

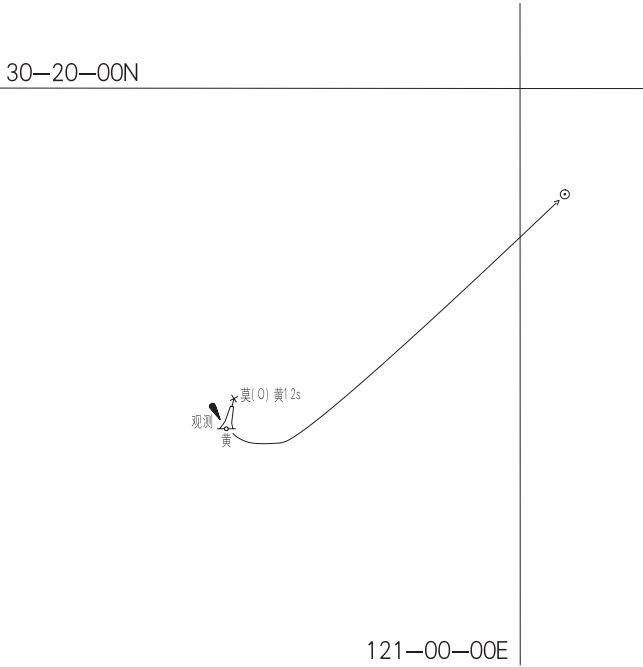



图号：55001	通告项号：2025 - 300
版时：2021.09	前次项号：2025 - 260


28-00-00N

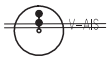

121-45-00E



图号：55631	通告项号：2025 - 301
版时：2023.03	前次项号：2025 - 67

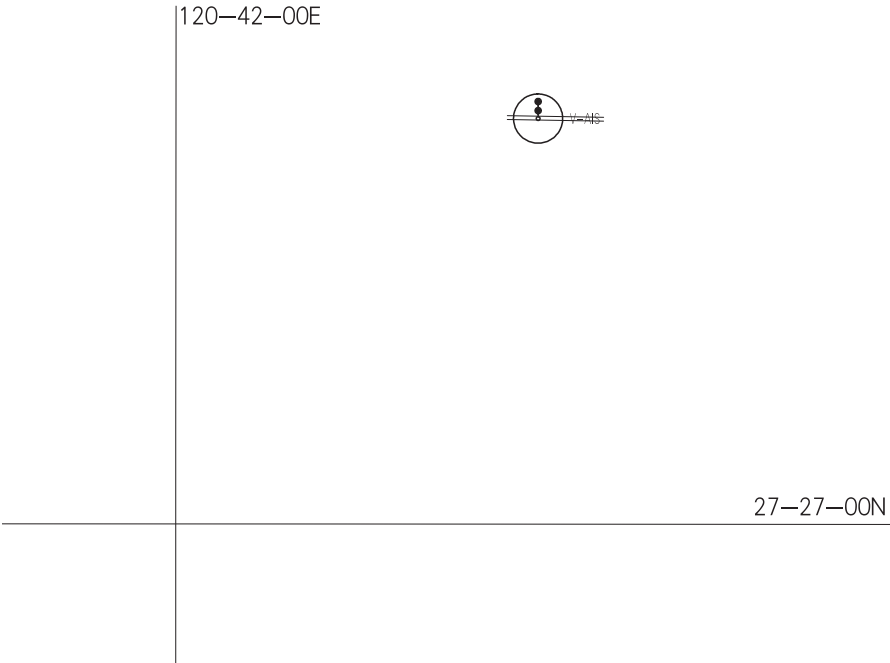



图号：55731	通告项号：2025 - 302
版时：2021.10	前次项号：2024 - 1296

27—21—00N

莫(0)黄15s 同步
~~莫(0)黄15s 同步~~
(L7)黄

莫(0)黄15s 同步
~~莫(0)黄15s 同步~~
苍南1号风电(L6)黄

120—50—54E



图号：61001	通告项号：2025 - 301
版时：2019.11	前次项号：2025 - 67

27—30—00N



120—45—00E



图号：61001	通告项号：2025 - 303
版时：2019.11	前次项号：2025 - 302

26—45—00N



120—30—00E



图号：61321	通告项号：2025 - 304
版时：2014.06	前次项号：2025 - 261

26—48—00N

涪屿特大桥(6) 等明暗4s3M
(9) 等明暗4s3M

119—48—00E



图号：62001	通告项号：2025 - 303
版时：2021.08	前次项号：2025 - 135


26—45—00N



120—30—00E




图号：64001	通告项号：2025 - 305
版时：2022.08	前次项号：2025 - 208

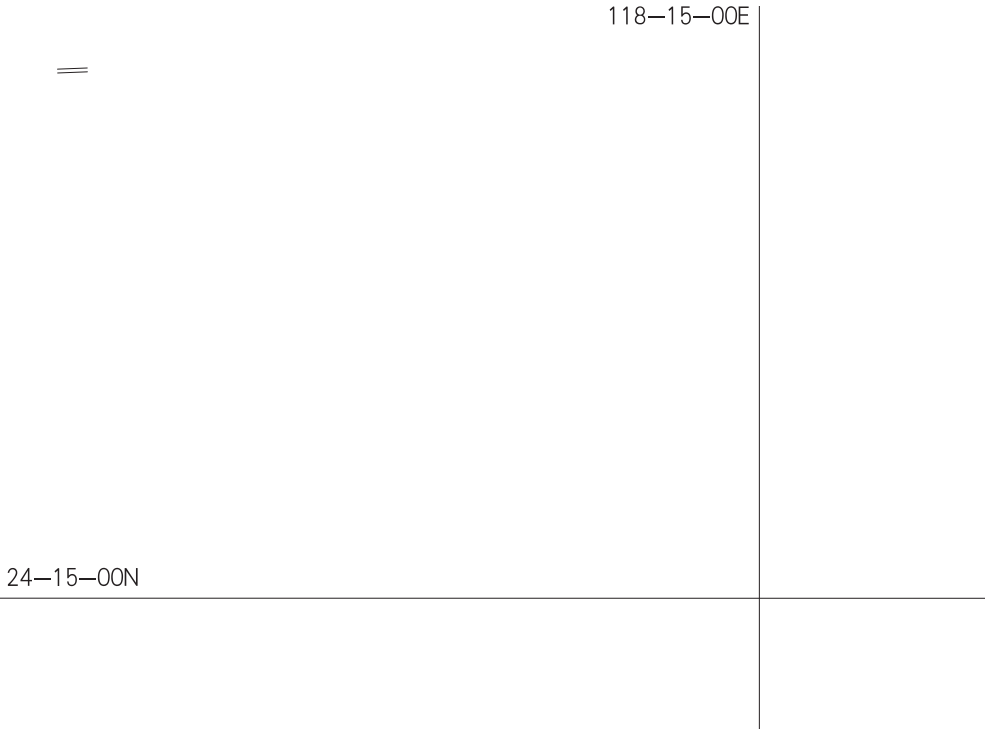




图号：65133	通告项号：2025 - 309
版时：2025.01	前次项号：2025 -

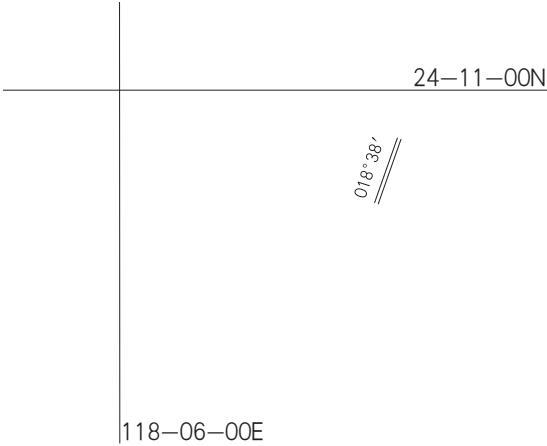


图号：65171	通告项号：2025 - 305
版时：2022.03	前次项号：2025 - 89

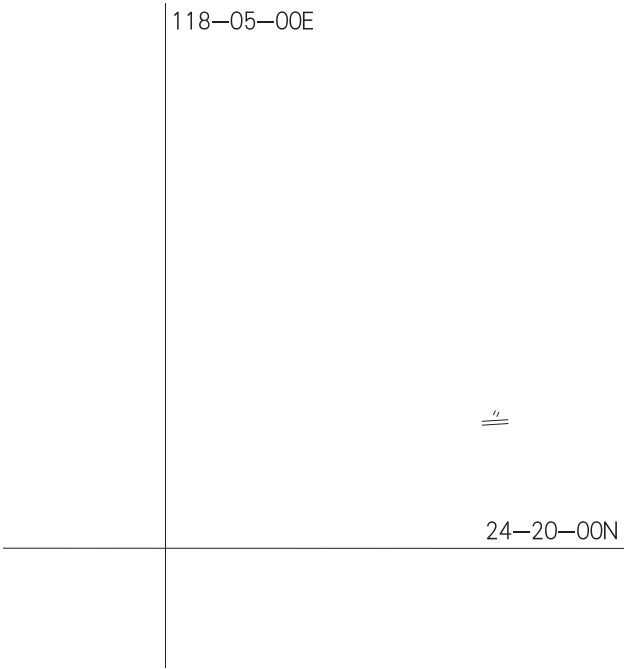




图号：2307	通告项号：2025 - 295
版时：2012.10	前次项号：2025 - 249

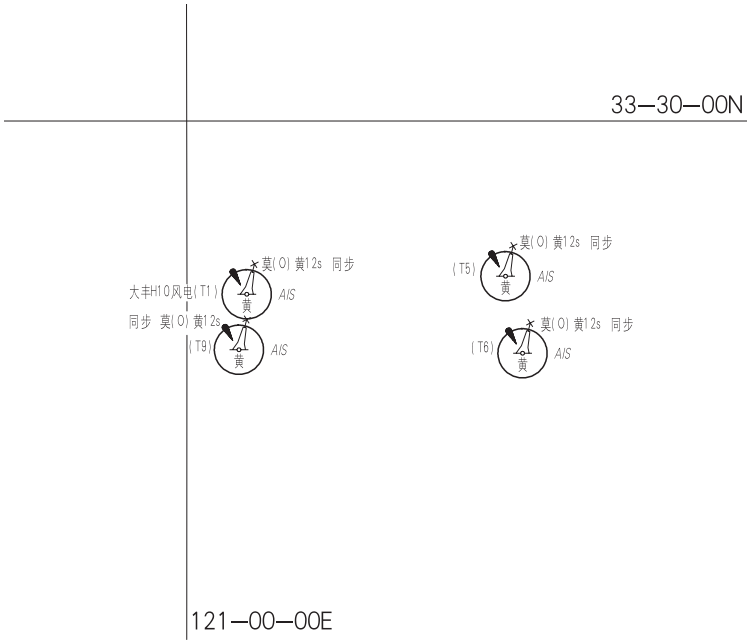



图号：2309	通告项号：2025 - 300
版时：2012.10	前次项号：2025 - 259

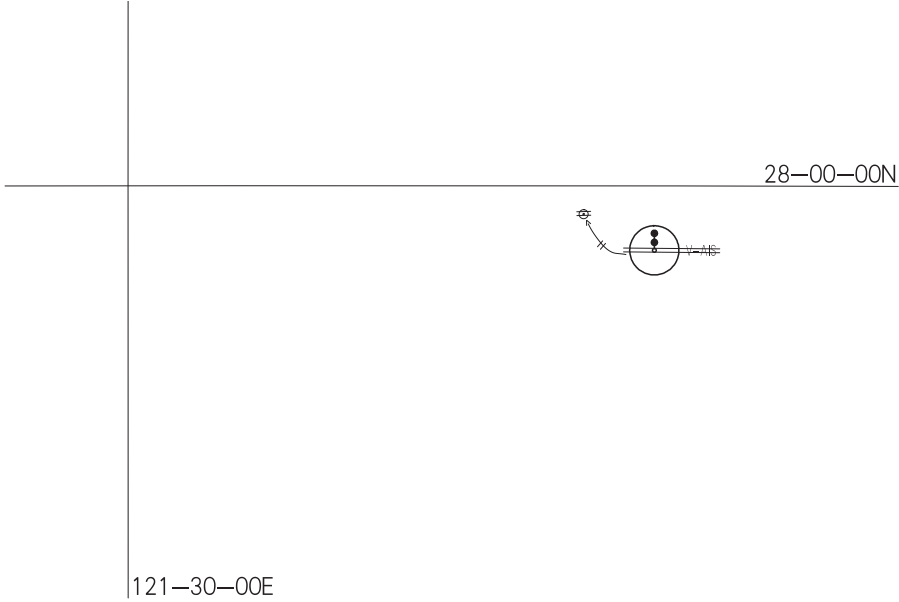


图号：2310	通告项号：2025 - 301
版时：2012.10	前次项号：2025 - 262





图号：2310	通告项号：2025 - 302
版时：2012.10	前次项号：2025 - 301

27—30—00N

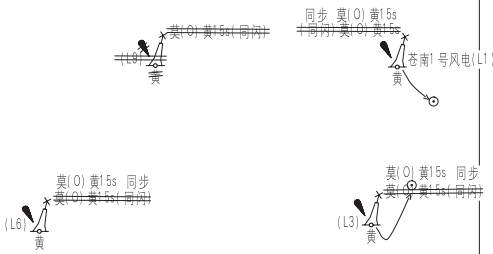

121—00—00E



图号：2310	通告项号：2025 - 303
版时：2012.10	前次项号：2025 - 302


27-00-00N



120-30-00E




图号：81001	通告项号：2025 - 306
版时：2021.03	前次项号：2025 - 275

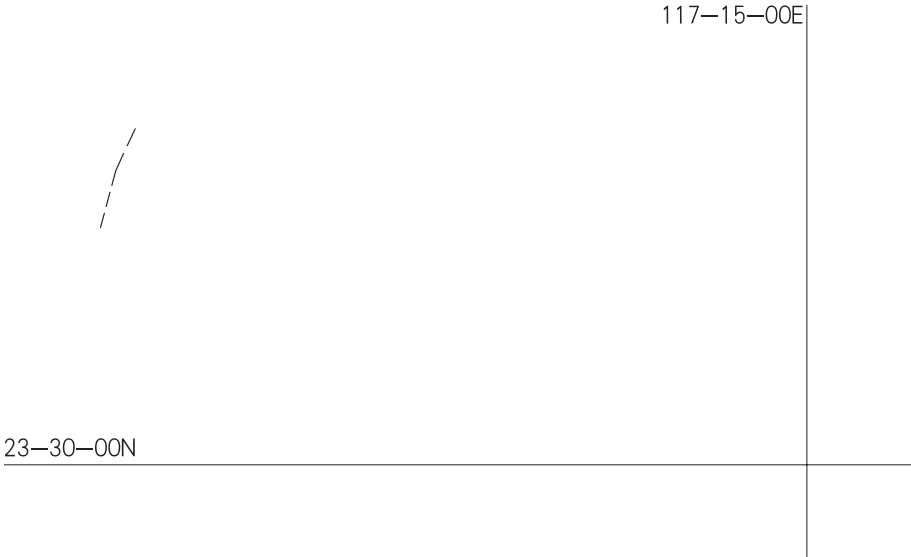




图号：81101	通告项号：2025 - 306
版时：2022.10	前次项号：2025 - 275

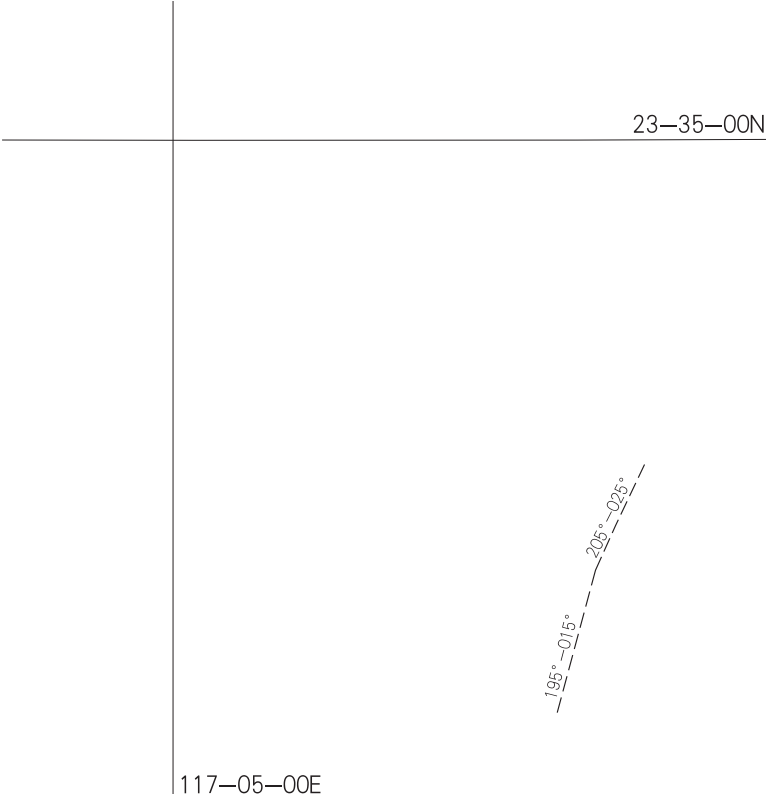



图号：81102	通告项号：2025 - 306
版时：2025.02	前次项号：2025 -


117-08-00E

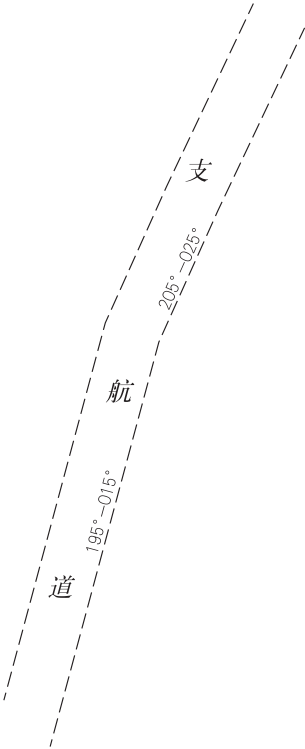

23-32-00N




图号：83001	通告项号：2025 - 307
版时：2023.12	前次项号：2025 - 278

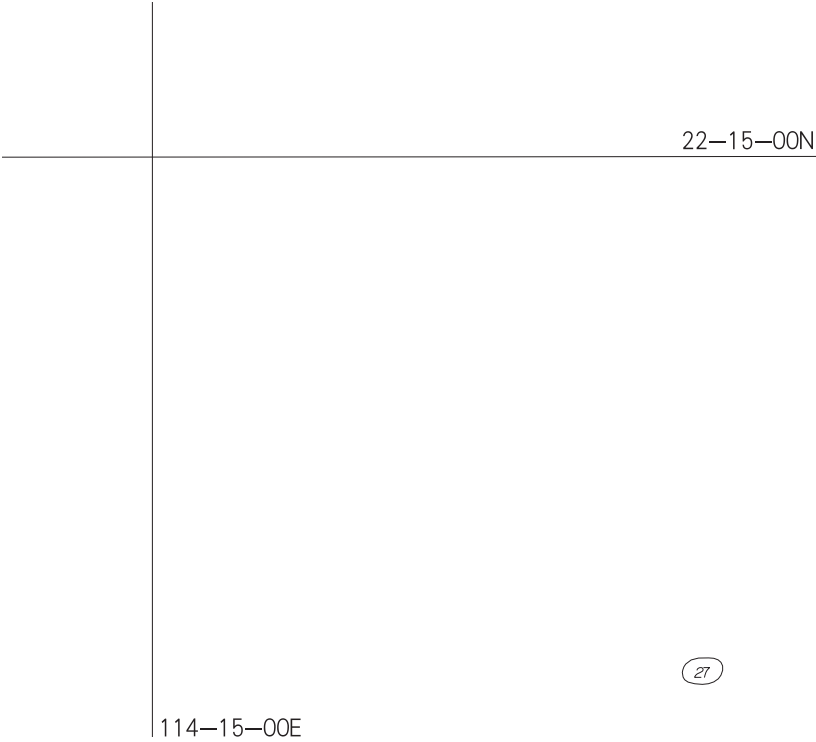




图号：84001	通告项号：2025 - 307
版时：2015.03	前次项号：2025 - 278

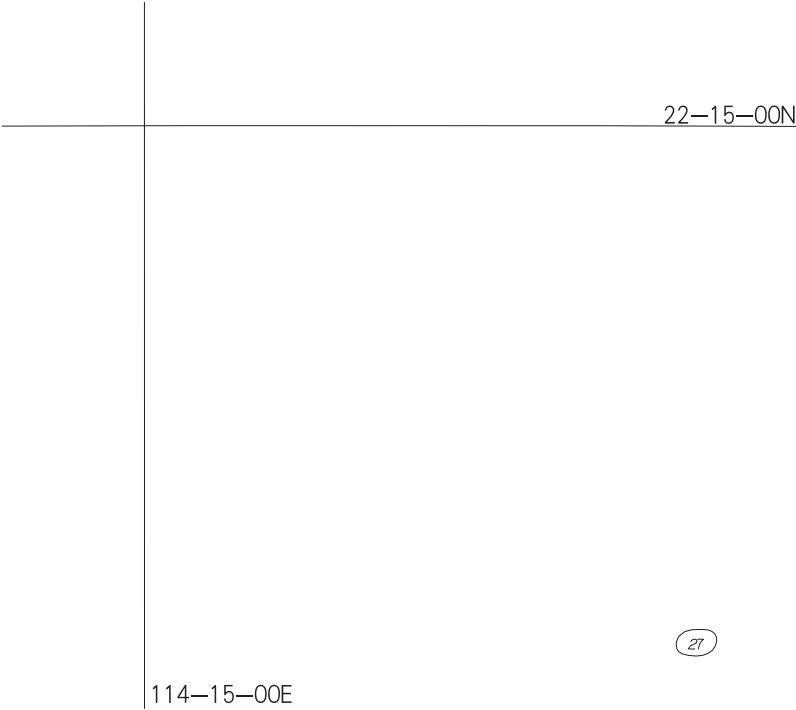



图号：84203	通告项号：2025 - 307
版时：2021.03	前次项号：2025 - 278

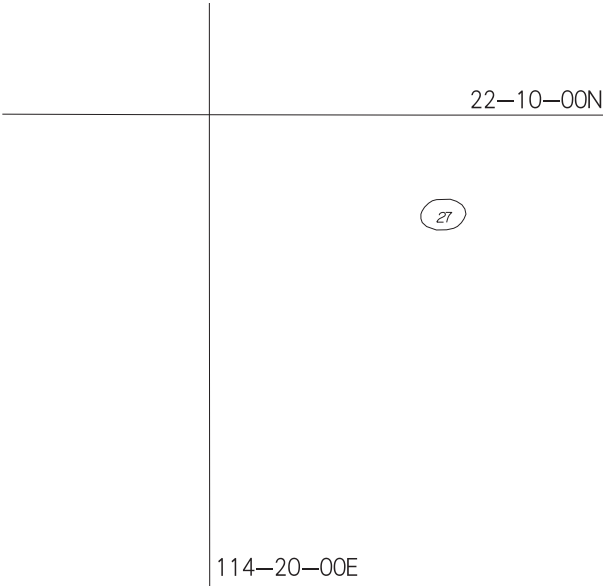

图号：3314	通告项号：2025 - 307
版时：2012.10	前次项号：2025 - 280

