





图号：12003	通告项号：2026 - 1009
版时：2017.03	前次项号：2026 - 906

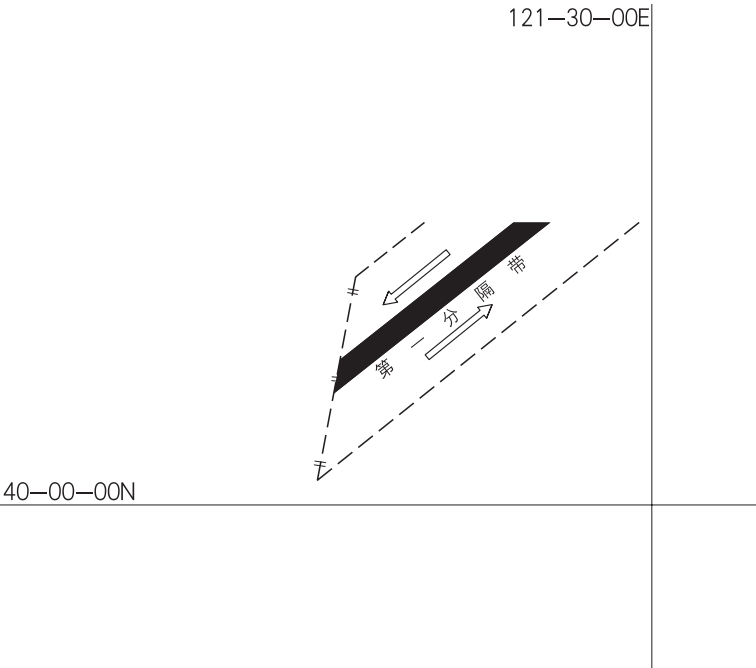


图号：12382	通告项号：2026 - 1009
版时：2024.11	前次项号：2026 - 825

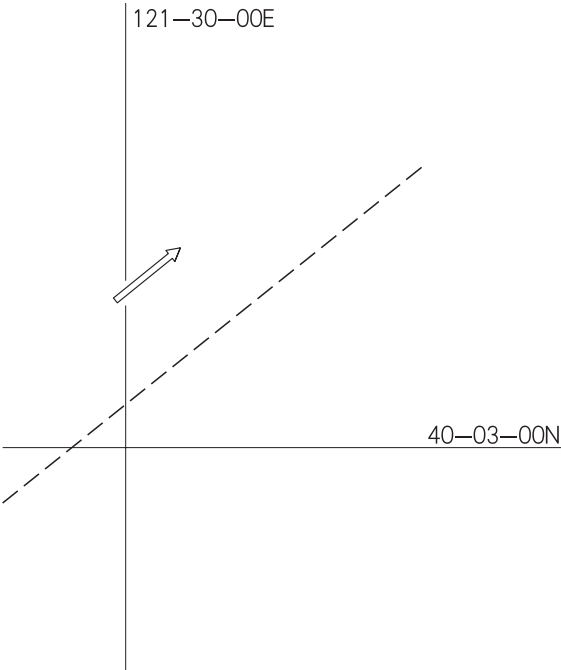




图号：13001	通告项号：2026-1009
版时：2021.02	前次项号：2026-939

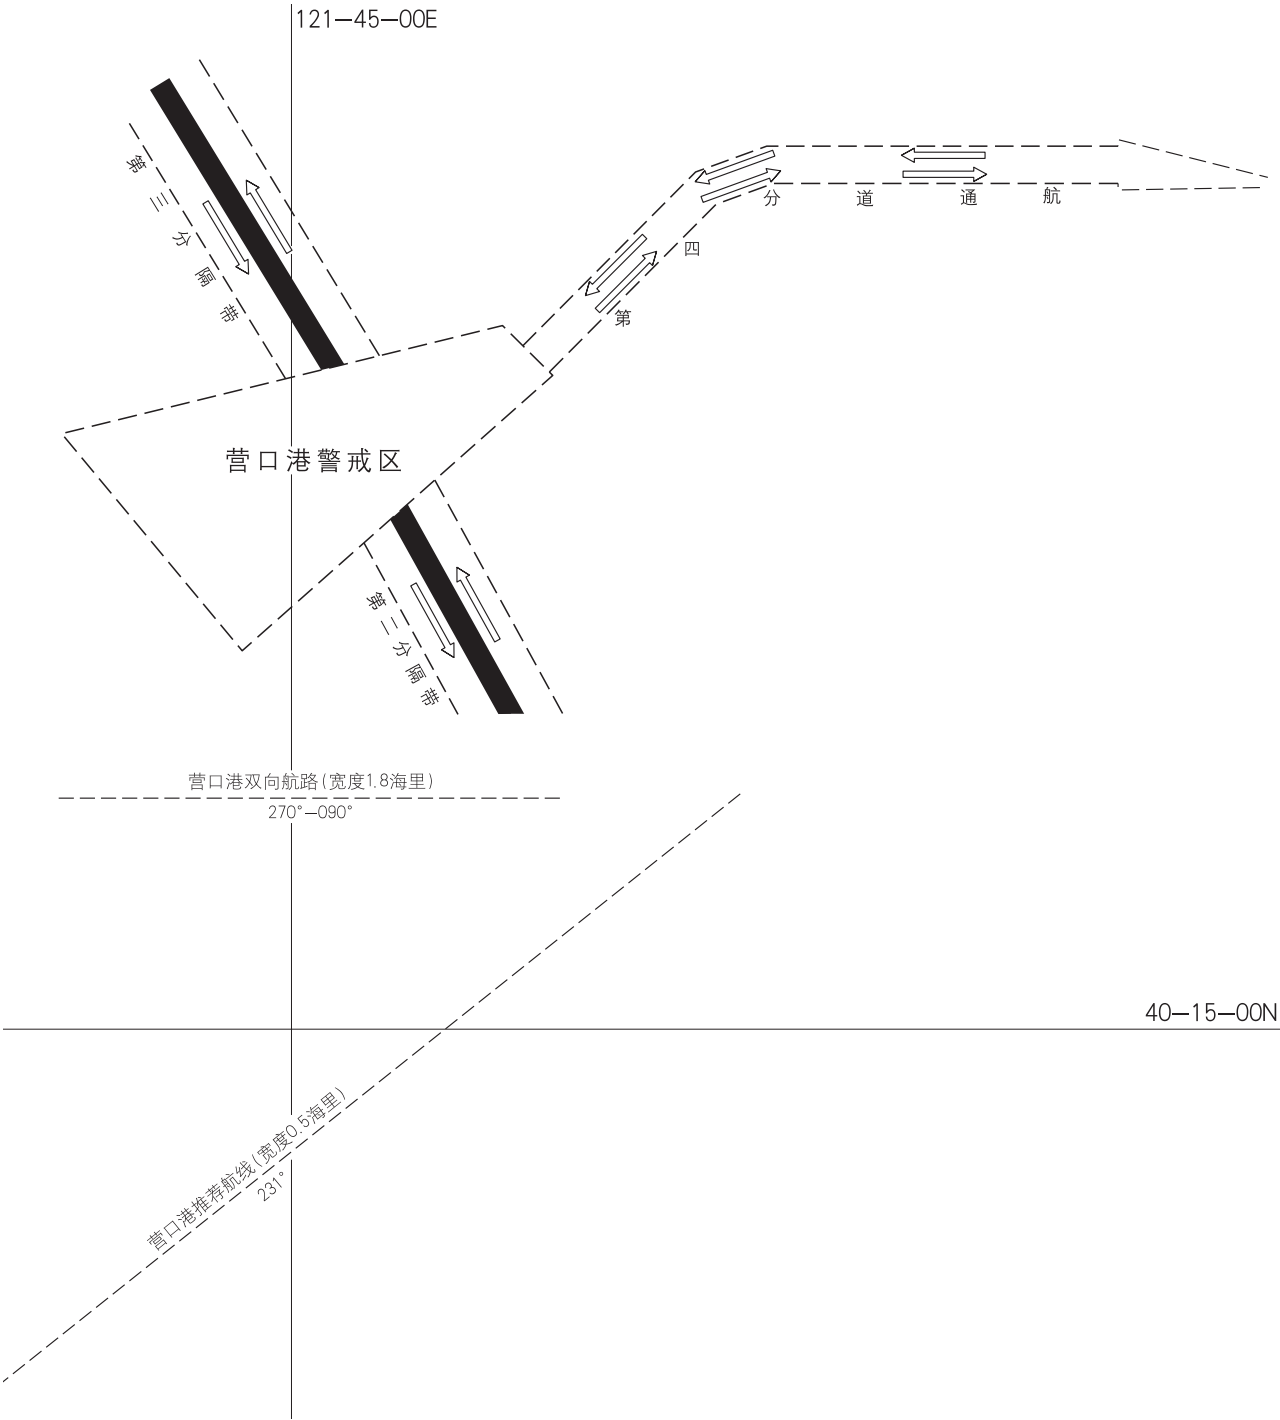




图号：13001	通告项号：2026 - 1009
版时：2021.02	前次项号：2026 - 939

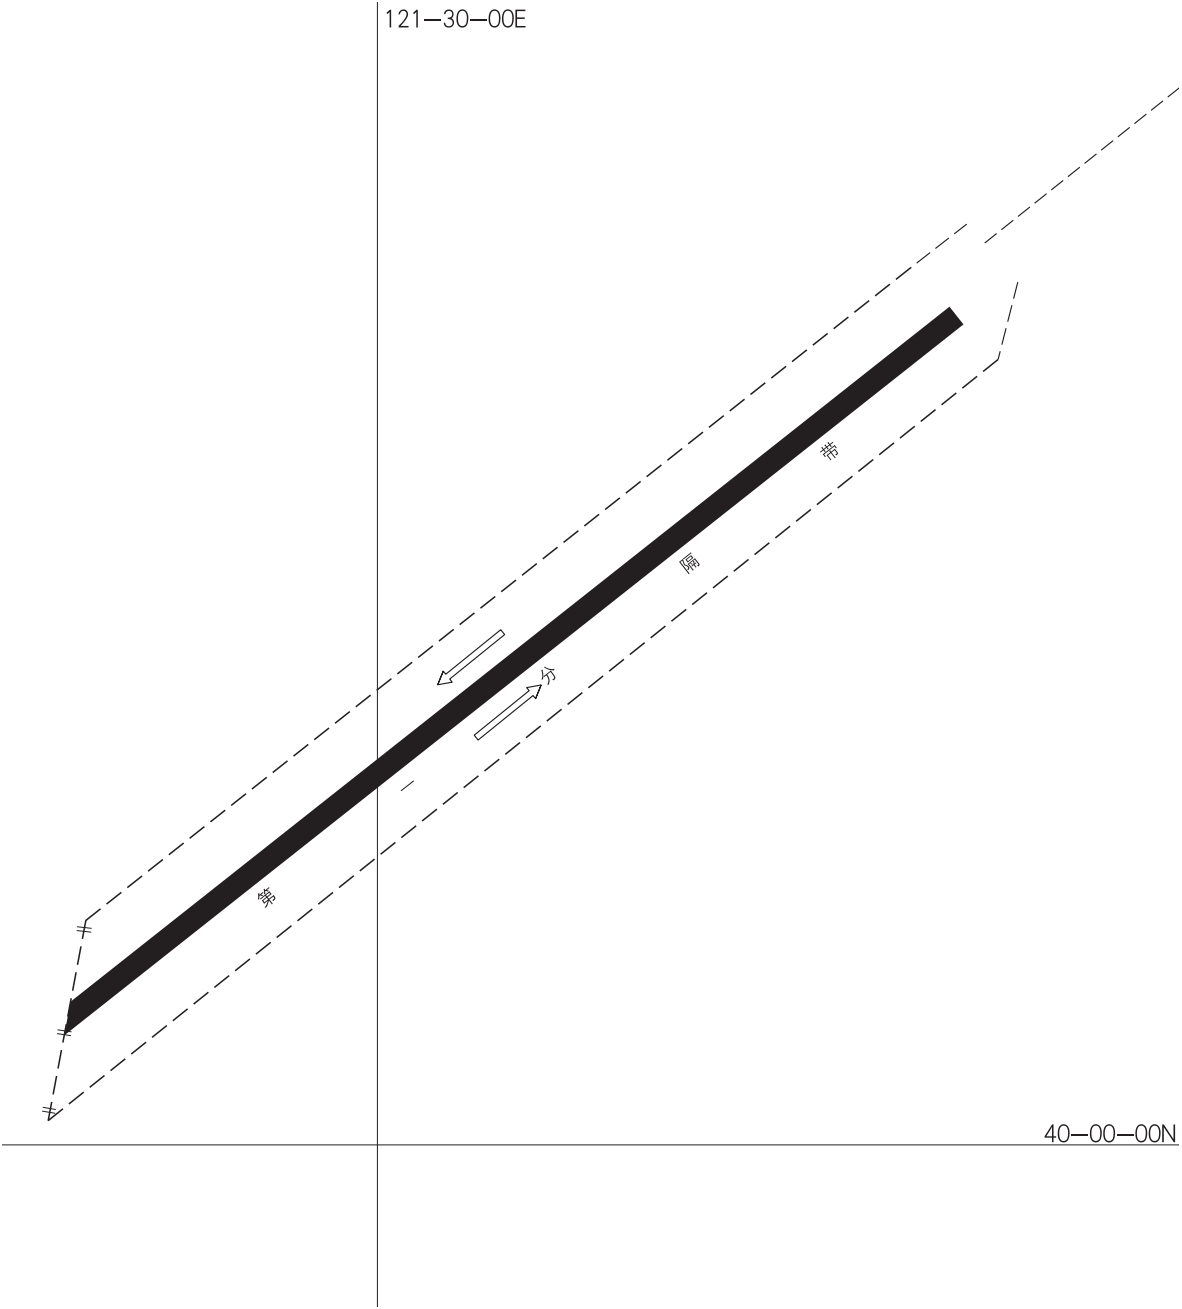




图号：13111	通告项号：2026 - 1009
版时：2025.03	前次项号：2026 - 939

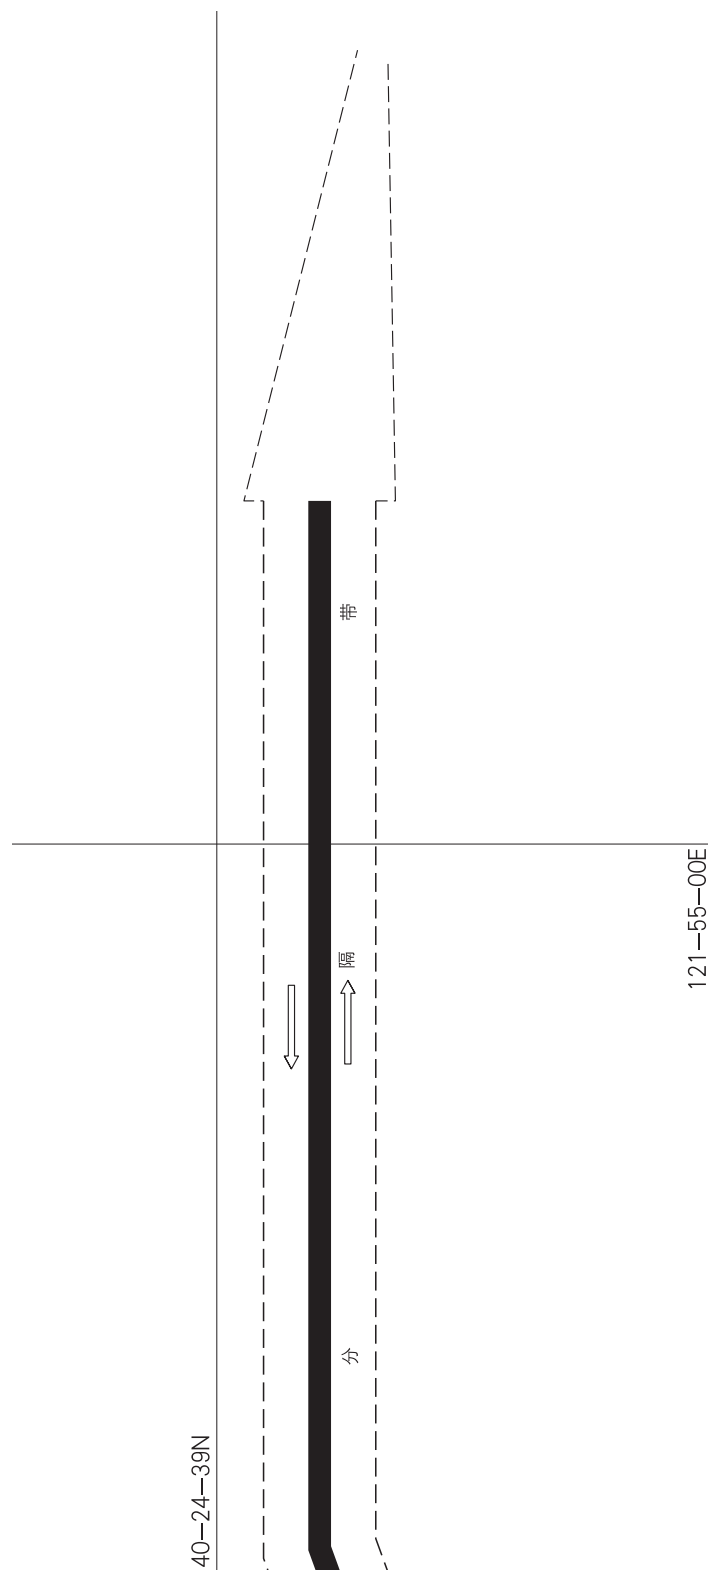



图号：13111	通告项号：2026 - 1009
版时：2025.03	前次项号：2026 - 939

40—24—39N

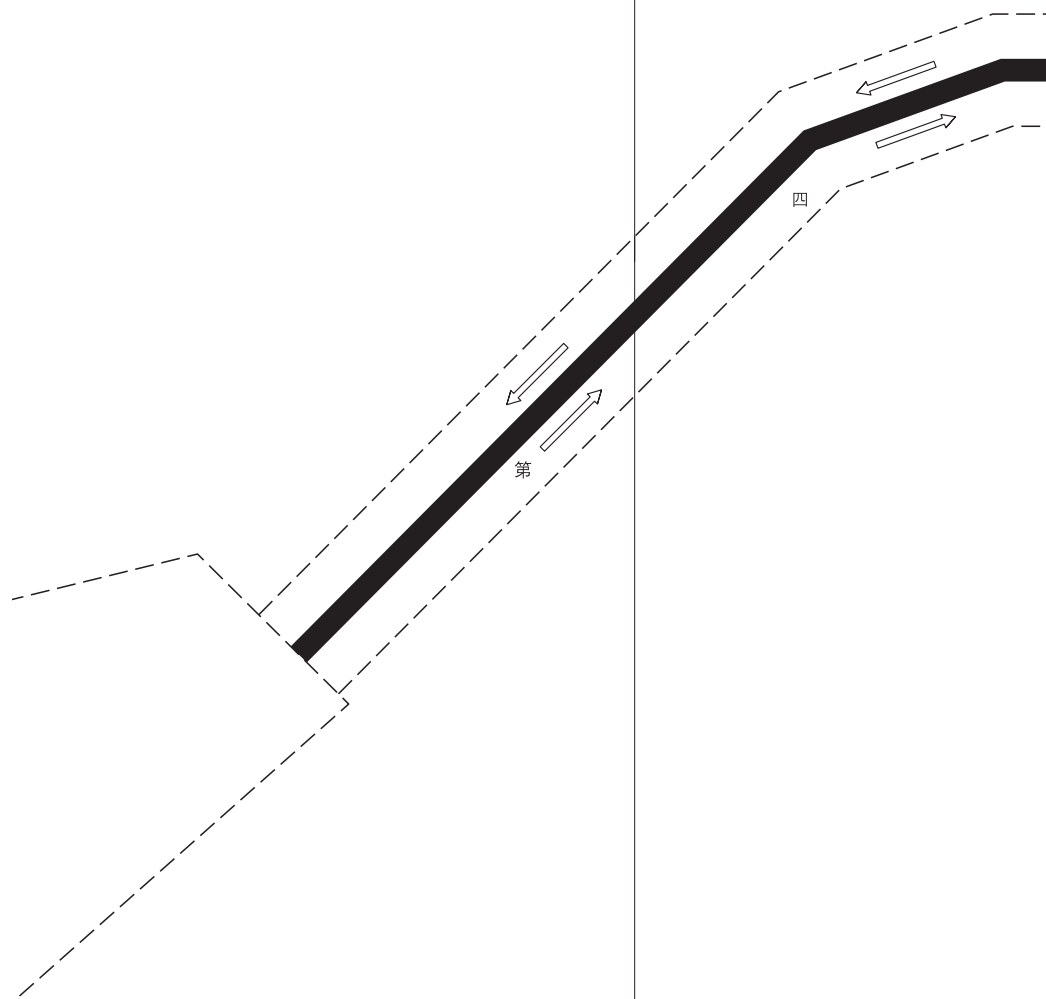


121—50—00E



图号：13111	通告项号：2026 - 1009
版时：2025.03	前次项号：2026 - 939


40-24-39N

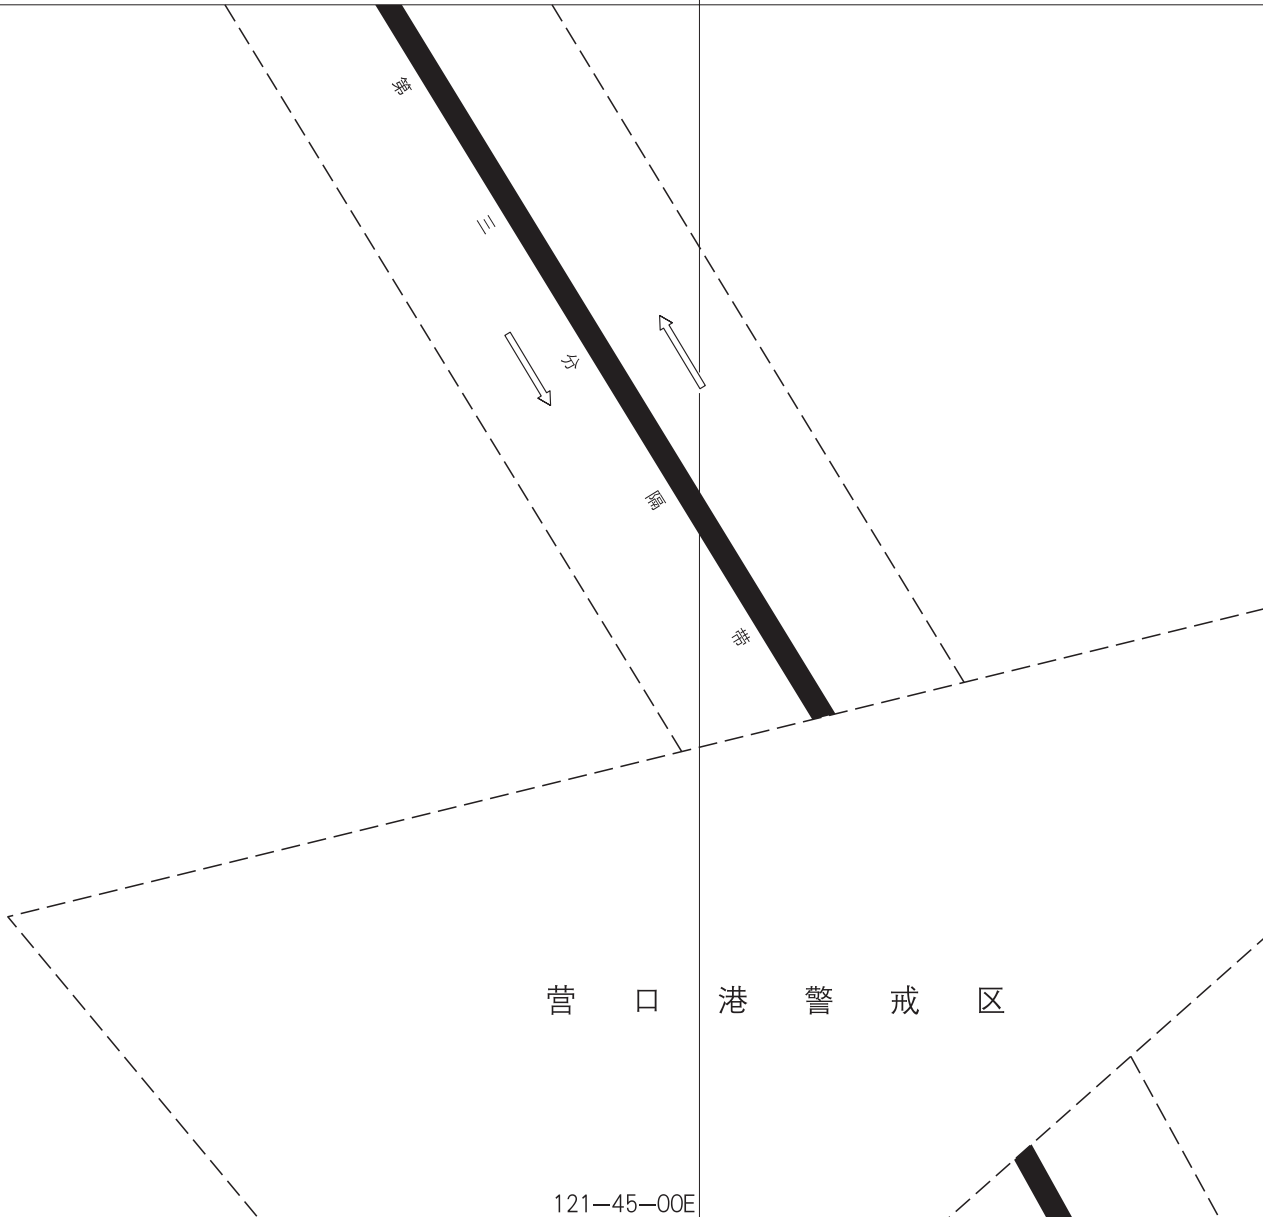

121-45-00E




图号：13111	通告项号：2026 - 1009
版时：2025.03	前次项号：2026 - 939

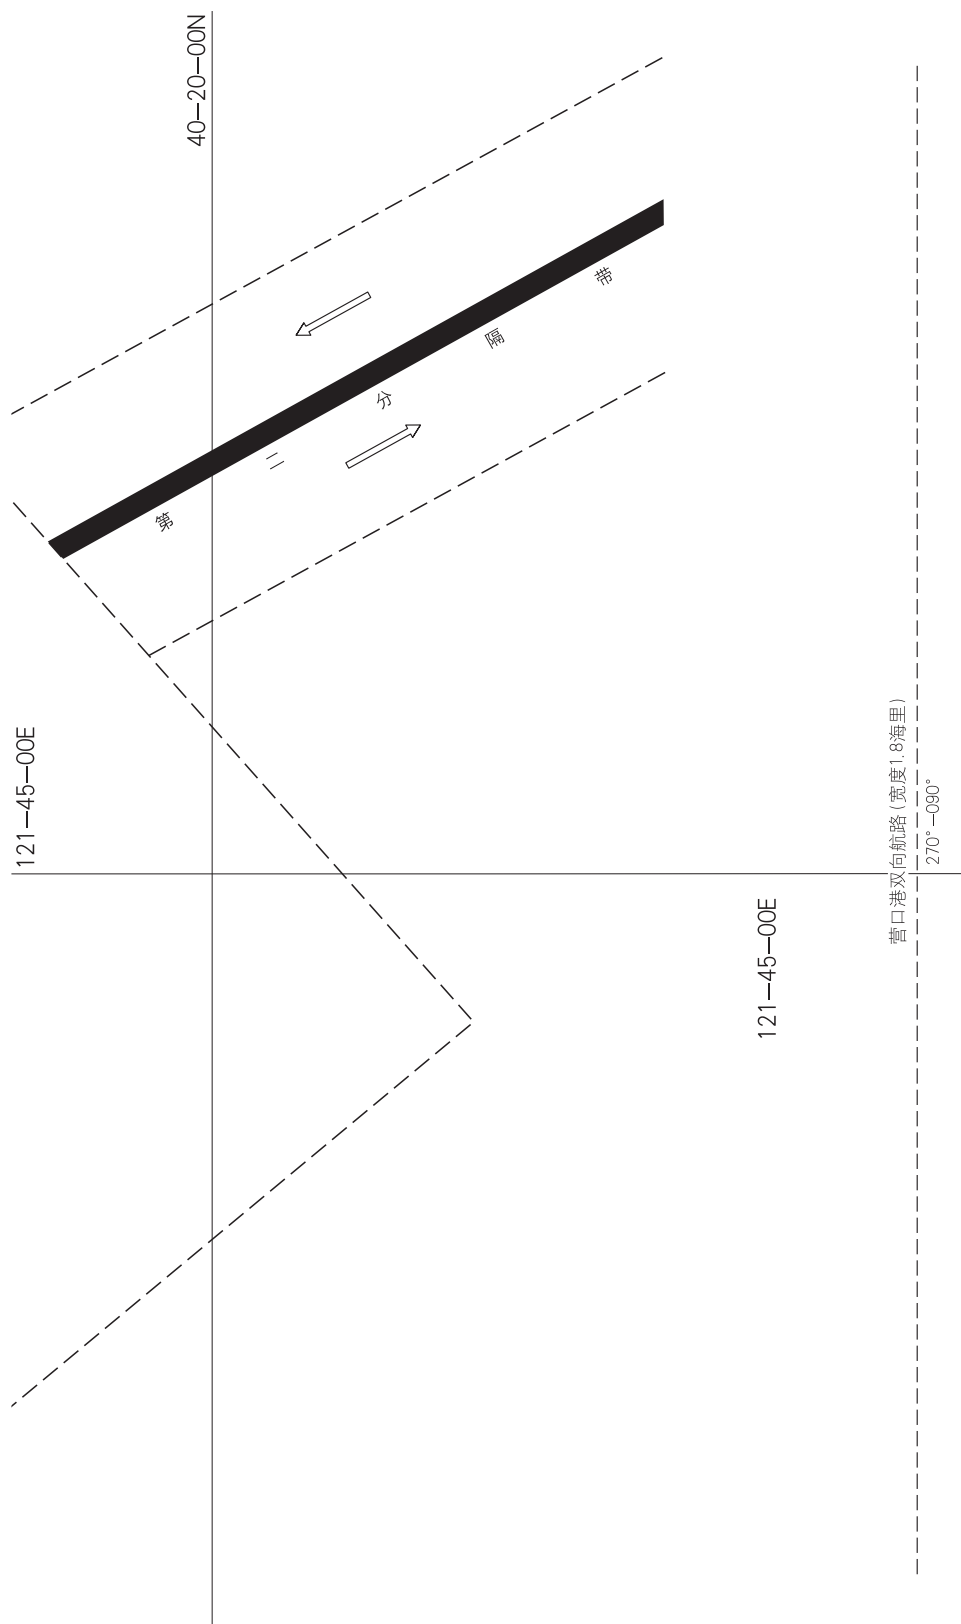




图号：13111	通告项号：2026 - 1009
版时：2025.03	前次项号：2026 - 939

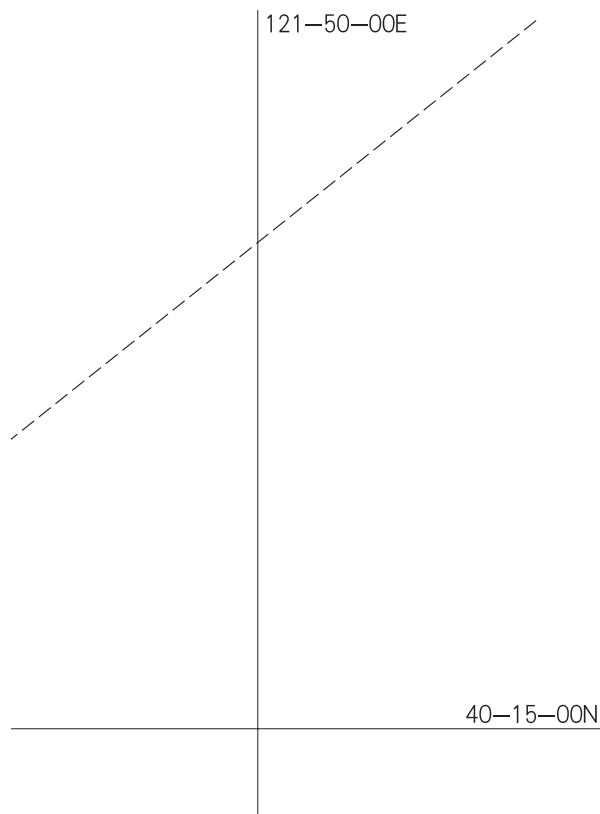




图号：13111	通告项号：2026 - 1009
版时：2025.03	前次项号：2026 - 939

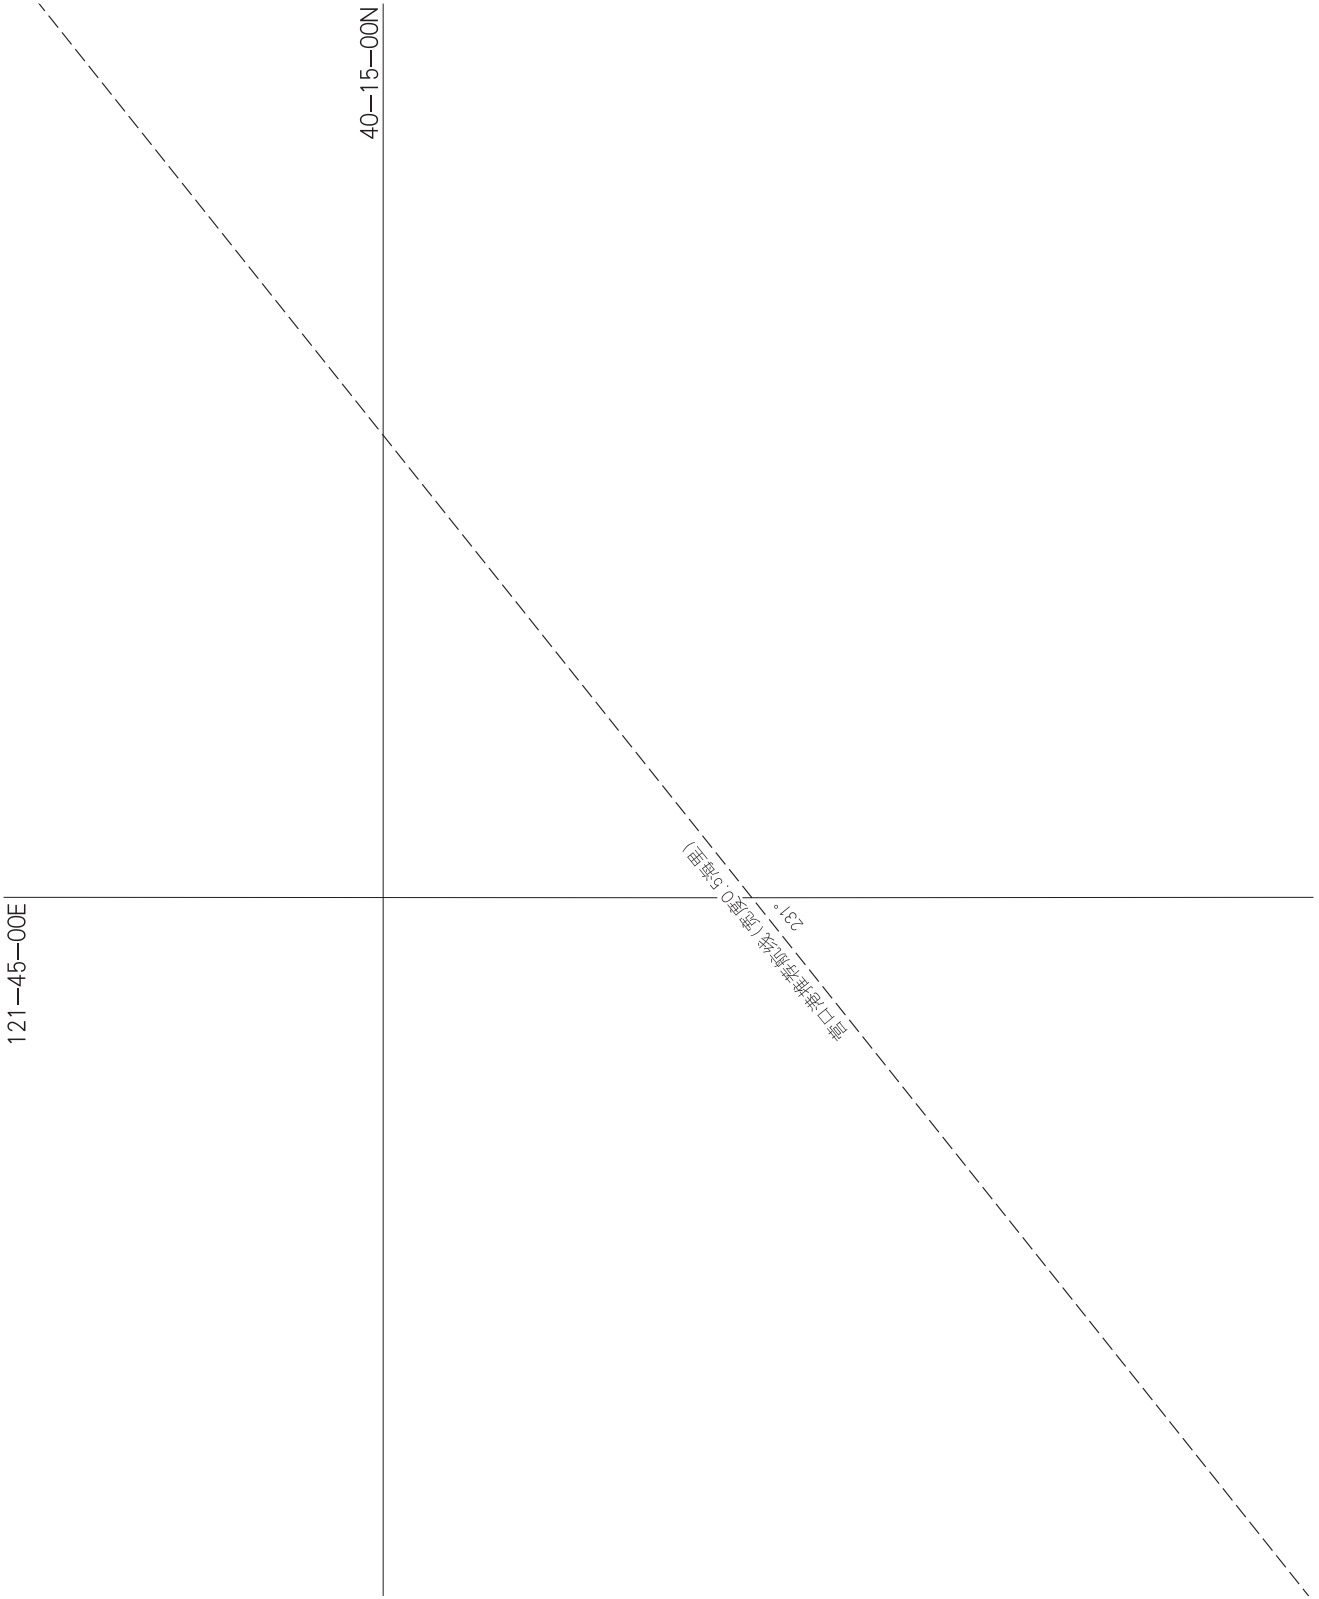




图号：13111	通告项号：2026-1009
版时：2025.03	前次项号：2026-939

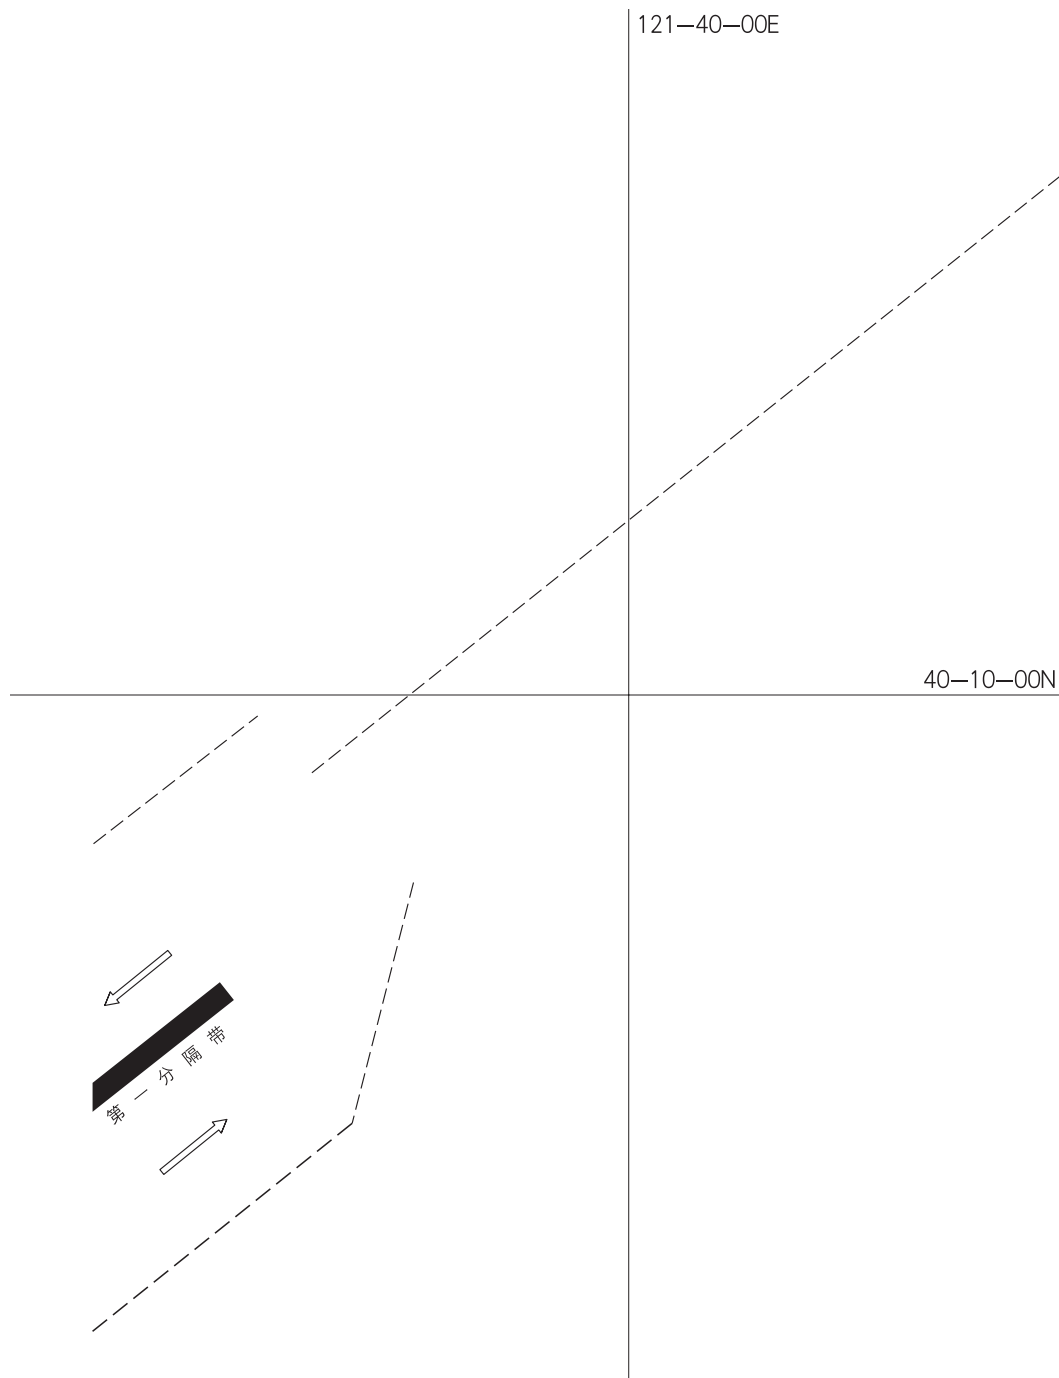




图号：13144	通告项号：2026 - 1009
版时：2026.02	前次项号：2026 - 494

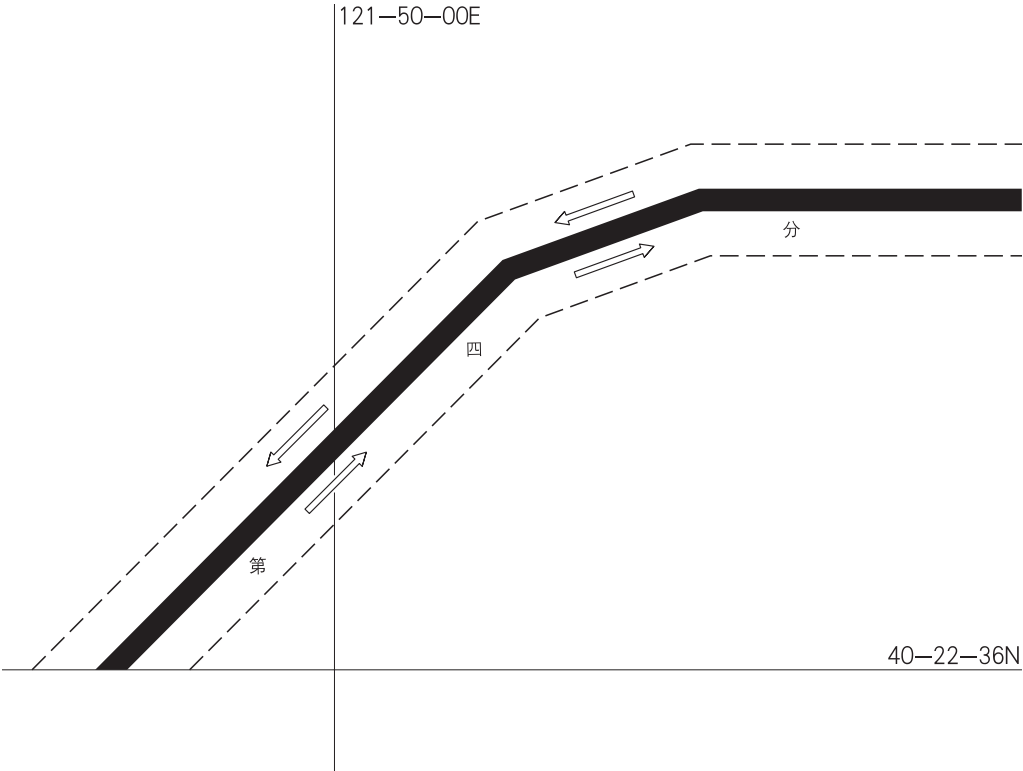

图号：13144	通告项号：2026 - 1009
版时：2026.02	前次项号：2026 - 494

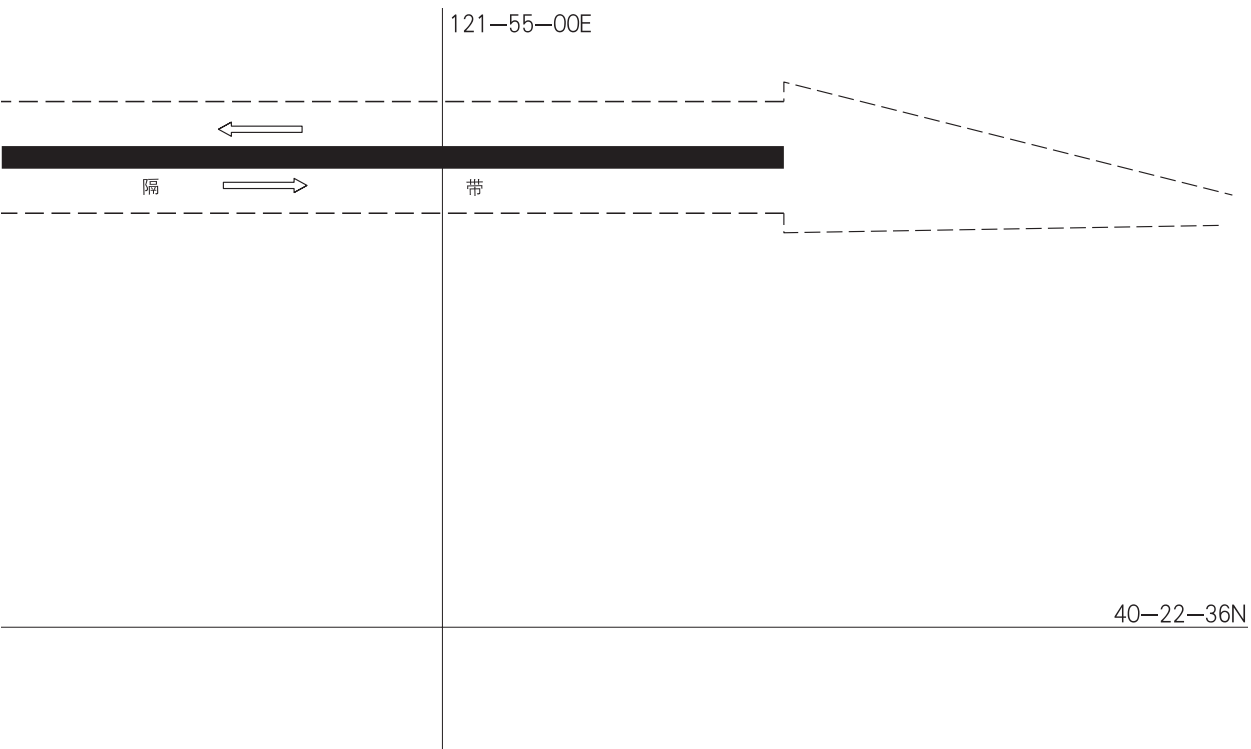



图号：22001	通告项号：2026 - 1010
版时：2024.09	前次项号：2026 - 834



118-45-00E

38-45-00N





图号：22001	通告项号：2026 - 1010
版时：2024.09	前次项号：2026 - 834

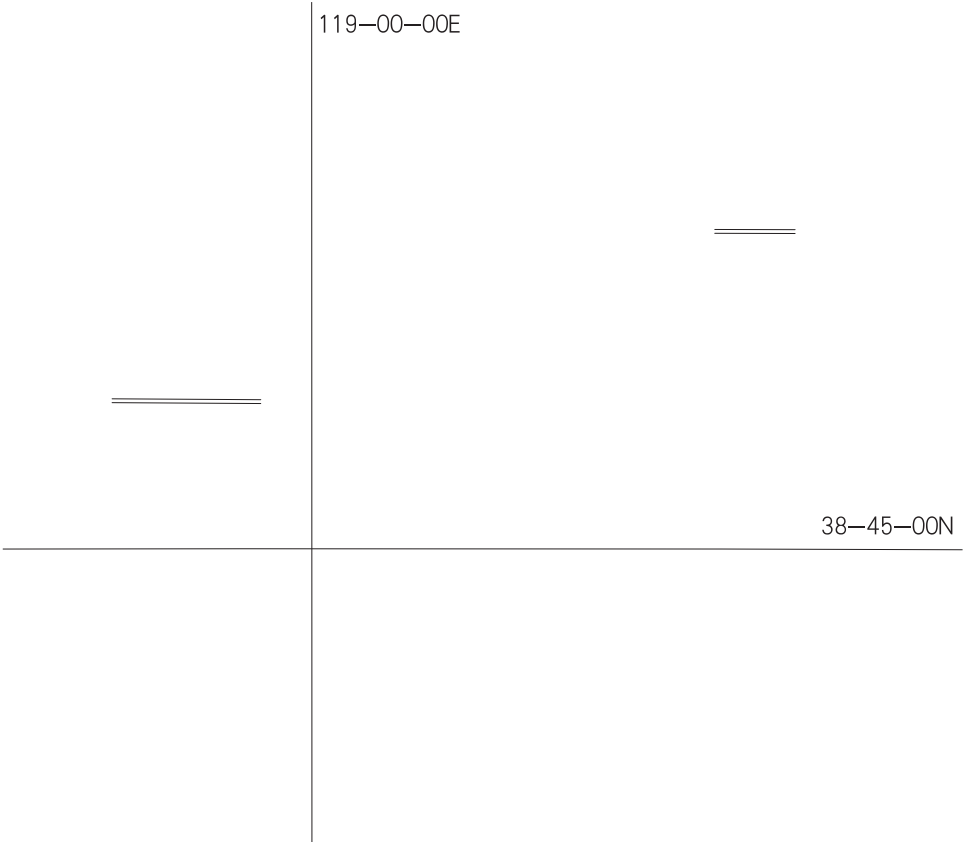




图 号 ： 22001	通告项号 ： 2026 - 1010
版 时 ： 2024.09	前次项号 ： 2026 - 834

119-45-00E

38-45-00N



图号：22001	通告项号：2026 - 1010
版时：2024.09	前次项号：2026 - 834

120-00-00E

25

39-15-00N




图号：22111	通告项号：2026 - 1010
版时：2025.01	前次项号：2026 - 616

39-00-00N

119-35-00E



图号：22122	通告项号：2026 - 1010
版时：2023.02	前次项号：2026 - 616

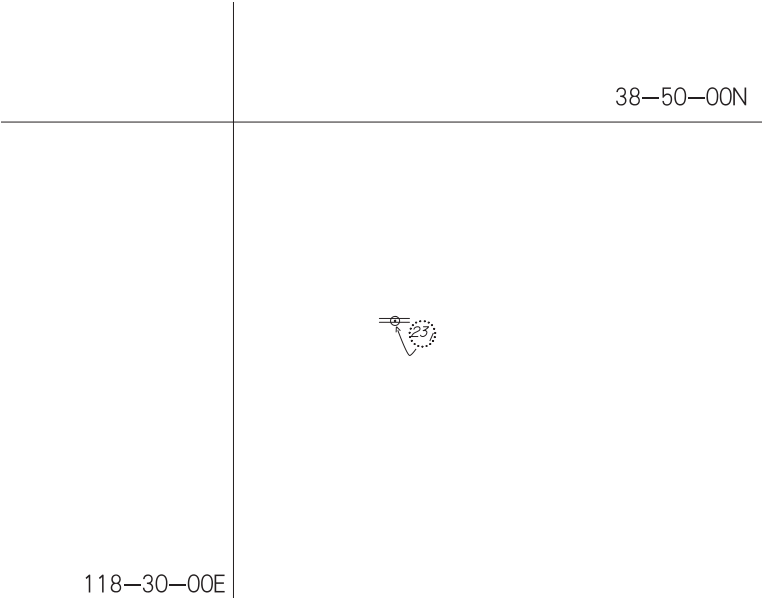

图号：23001	通告项号：2026 - 1010
版时：2020.06	前次项号：2026 - 966





图号：23001	通告项号：2026 - 1011
版时：2020.06	前次项号：2026 - 1010

38—30—00N

倾倒区

118—43—00E



图号：32001	通告项号：2026 - 1010
版时：2023.03	前次项号：2026 - 834

118—45—00E

=

38—30—00N



图号：32001	通告项号：2026 - 1010
版时：2023.03	前次项号：2026 - 834

38-45-00N

119-45-00E



图号：32001	通告项号：2026 - 1011
版时：2023.03	前次项号：2026 - 1010


38-30-00N

倾倒区


118-45-00E



图号：32001	通告项号：2026 - 1013
版时：2023.03	前次项号：2026 - 1011

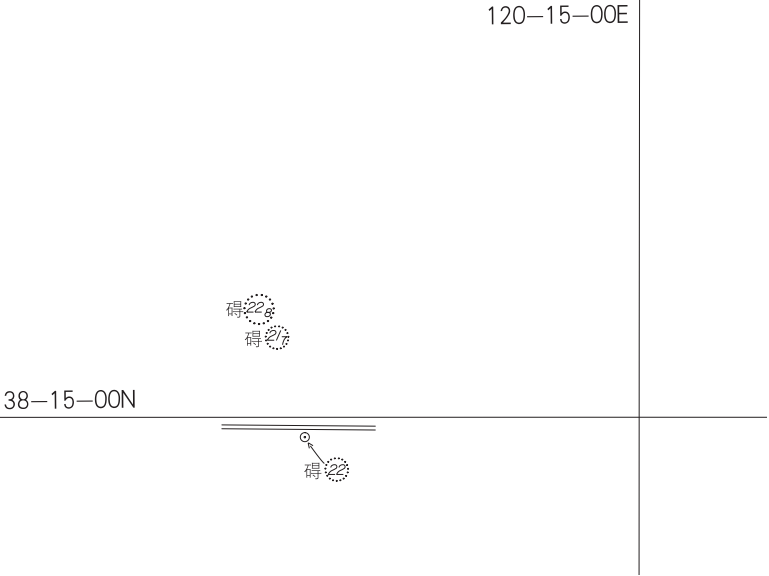


图号：33001	通告项号：2026 - 1012
版时：2020.03	前次项号：2026 - 969

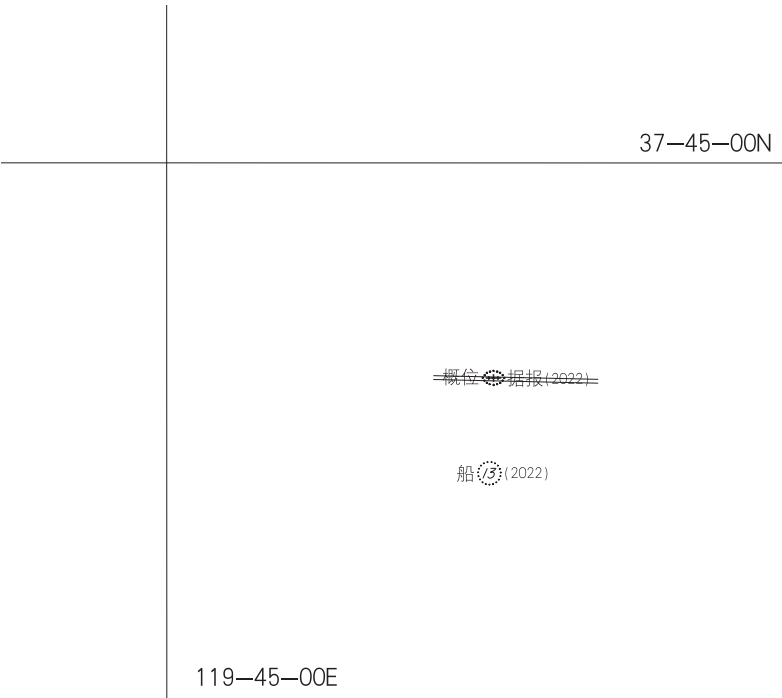




图号：34001	通告项号：2026 - 1013
版时：2025.03	前次项号：2026 - 623

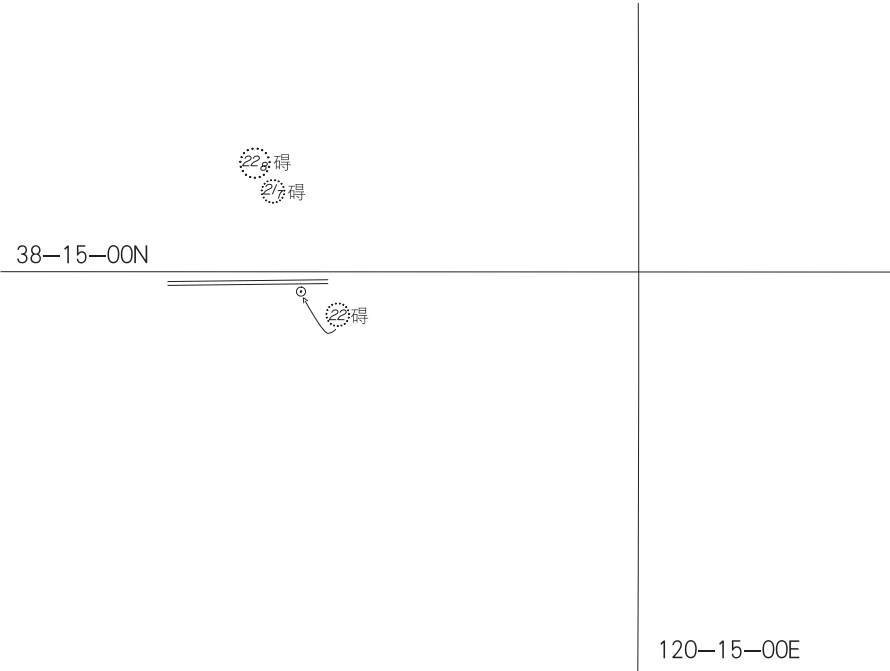

图号：34112	通告项号：2026 - 1012
版时：2025.11	前次项号：2026 - 969

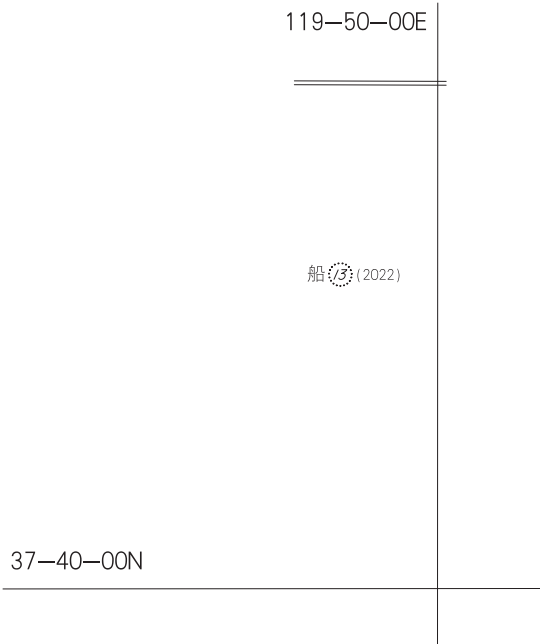



图号：36001	通告项号：2026 - 1014
版时：2024.09	前次项号：2026 - 628

36—15—00N



121—00—00E



图号：36144	通告项号：2026 - 1015
版时：2024.12	前次项号：2026 - 835


120—10—00E




35—30—00N



图号：37001	通告项号：2026 - 1015
版时：2023.01	前次项号：2026 - 835

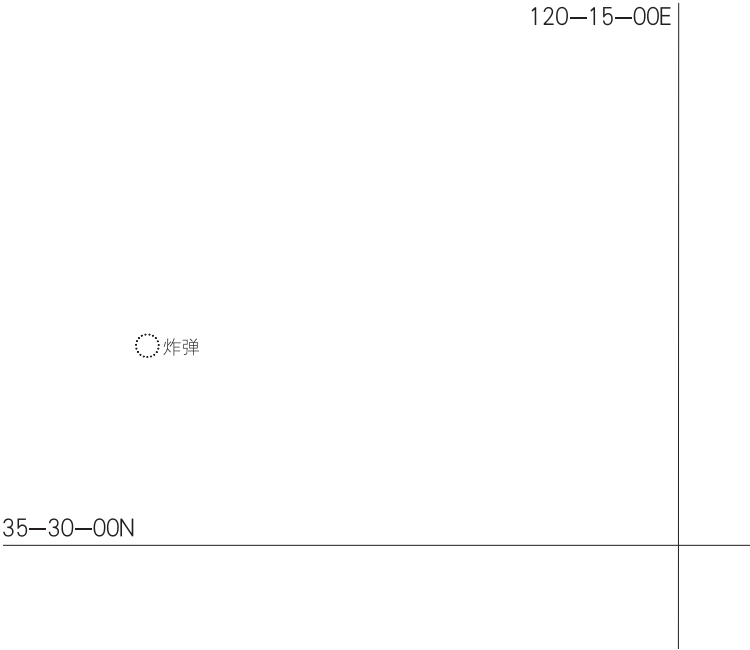


图号：1301	通告项号：2026 - 1009
版时：2016.03	前次项号：2026 - 858

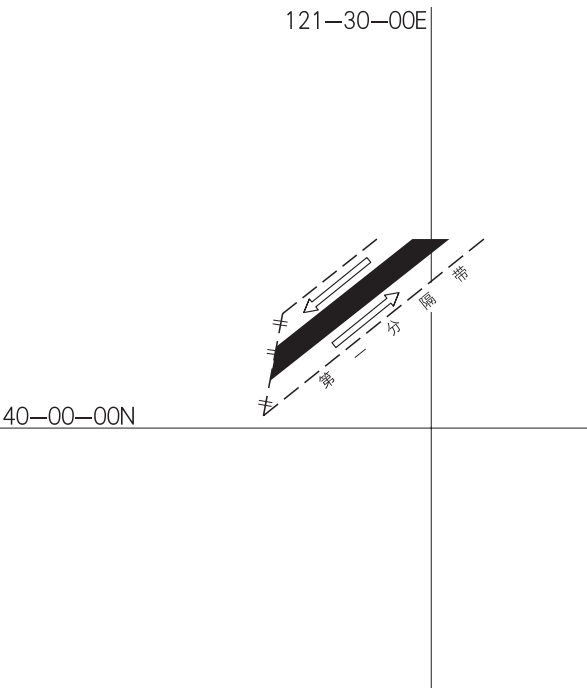



图号：1302	通告项号：2026 - 1013
版时：2016.03	前次项号：2026 - 906

120-00-00E

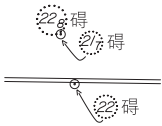


38-00-00N




图号：1303	通告项号：2026-1009
版时：2012.10	前次项号：2026-939

121-30-00E

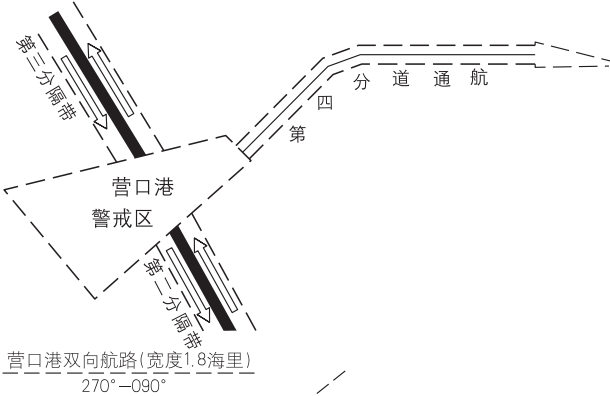

营口港推荐航线 (宽度0.5海里)
231°

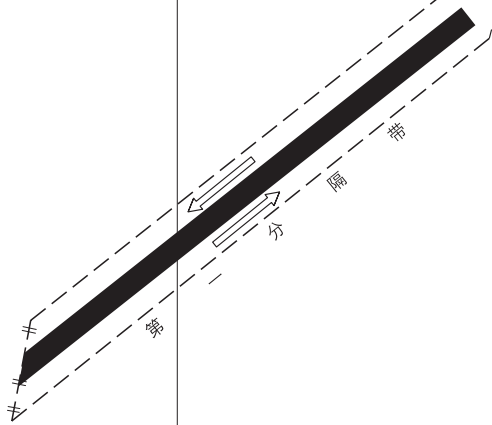

40-00-00N



图 号 ： 1303	通 告 项 号 ： 2026 - 1010
版 时 ： 2012.10	前 次 项 号 ： 2026 - 1009

120-00-00E

25

39-10-00N



图号：1304	通告项号：2026 - 1010
版时：2017.03	前次项号：2026 - 969

118—30—00E



119—00—00E



38—30—00N



图号：1304	通告项号：2026 - 1010
版时：2017.03	前次项号：2026 - 969

25

39-00-00N

~~概位 据报(2017)~~

~~概位 据报(2018)~~

==

120-00-00E



图号：1304	通告项号：2026 - 1011
版时：2017.03	前次项号：2026 - 1010

38—30—00N

倾倒区

119—00—00E



图号：1304	通告项号：2026 - 1012
版时：2017.03	前次项号：2026 - 1011

120—00—00E


概位 据报 (2022)
13 船
(2022)

37—30—00N



图号：1304	通告项号：2026 - 1013
版时：2017.03	前次项号：2026 - 1012

120-00-00E

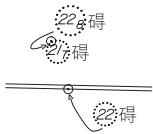

38-00-00N



图号：1305	通告项号：2026 - 1014
版时：2015.05	前次项号：2026 - 628

121-00-00E



36-00-00N



图号：1306	通告项号：2026 - 1014
版时：2012.10	前次项号：2026 - 679

121-00-00E

炸弹

36-00-00N



图号：1306	通告项号：2026 - 1015
版时：2012.10	前次项号：2026 - 1014

120-00-00E

炸弹

35-30-00N



图号：44213	通告项号：2026 - 1016
版时：2024.12	前次项号：2026 - 416

121-29-00E

67

31-02-00N



图号：44213	通告项号：2026 - 1016
版时：2024.12	前次项号：2026 - 416

121-29-00E



31-01-00N



图号：44213	通告项号：2026 - 1016
版时：2024.12	前次项号：2026 - 416

31-01-00N

碍

121-28-00E



图号：44213	通告项号：2026 - 1016
版时：2024.12	前次项号：2026 - 416

121-26-00E

$\frac{10}{3}$

6_5

31-00-00N



图号：84247	通告项号：2026 - 1017
版时：2022.09	前次项号：2023 - 550

113-30-00E



22-34-00N